

15-109-00008-00-00

STATE OF KANSAS
STATE CORPORATION COMMISSION

WELL PLUGGING RECORD

Give All Information Completely
Make Required Affidavit


Mail or Deliver Report to:
Conservation Division
State Corporation Commission
800-Dating-Building
Wichita, Kansas

2117 Broadway

Logan

County, Sec. 36 Twp. 13S Rge. 34 (W)

NORTH

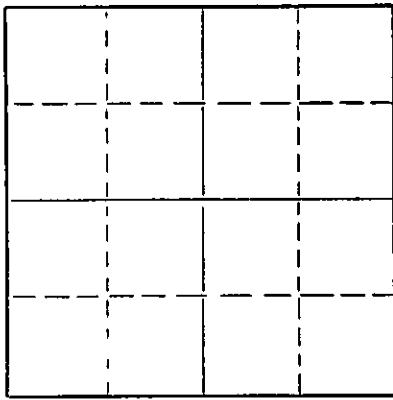

Locate well correctly on above
Section Plat

Location as "NE/CNWKSWK" or footage from lines SE SE SE
Lease Owner Johnie S. Carter
Lease Name Ross Well No. 1
Office Address P.O. Box 194, Fairfield, Illinois
Character of Well (completed as Oil, Gas or Dry Hole) Dry Hole
Date well completed Dec. 16 1957
Application for plugging filed Dec. 16 1957
Application for plugging approved Dec. 16 1957
Plugging commenced Dec. 16 1957
Plugging completed Dec. 16 1957
Reason for abandonment of well or producing formation Dry Hole

If a producing well is abandoned, date of last production _____ 19____
Was permission obtained from the Conservation Division or its agents before plugging was commenced? Yes

Name of Conservation Agent who supervised plugging of this well Eldon R. Petty
Producing formation _____ Depth to top _____ Bottom _____ Total Depth of Well 5065 Feet
Show depth and thickness of all water, oil and gas formations.

OIL, GAS OR WATER RECORDS

CASING RECORD

FORMATION	CONTENT	FROM	TO	SIZE	PUT IN	PULLED OUT
	No show					

Describe in detail the manner in which the well was plugged, indicating where the mud fluid was placed and the method or methods used in introducing it into the hole. If cement or other plugs were used, state the character of same and depth placed, from _____ feet to _____ feet for each plug set.

Hole filled with mud from 5065' to 300'. Bridge Plug set with 20 sacks cement. 300' to 40' Mud. Bridge Plug-set with 10 sacks cement.
Hole plugged.

01-08-58

(If additional description is necessary, use BACK of this sheet)

Name of Plugging Contractor _____
Address _____

STATE OF ILLINOIS COUNTY OF WAYNE, ss.
Harry J. Phillips (employee of owner) or ~~(owner)~~ of the above-described well, being first duly sworn on oath, says: That I have knowledge of the facts, statements, and matters herein contained and the log of the above-described well as filed and that the same are true and correct. So help me God.

(Signature) Harry J. Phillips
For: JOHNIE S. CARTER DRUG CONTR.
P. O. Box 194, Fairfield, Ill.

SUBSCRIBED AND SWORN TO before me this 30th day of December, 1957

My commission expires March 22, 1959
Judith A. Mitchell Notary Public,
Commissioned & residing in Richland Co., Ill.
acting in Wayne Co., Ill.

PLUGGING
SEC 36 T 13 R 34
BOOK PAGE 70 LINE 39

JOHNNIE S. CARTER DRILLING CONTRACTOR
 P. O. Box 194
 Fairfield, Illinois

Log of ROSS #1, Logan County, Kansas

COMPANY: Johnnie S. Carter
 CONTRACTOR: Johnnie S. Carter
 LEASE: ROSS #1
 LOCATION: SE SE SE
 Sec 36-13S-34W
 Logan County, Kansas

ELEVATION: 2842 G.L.

CASING RECORD: Set 112'
 8-5/8" Surface @ 118'
 w/200 sacks

COMMENCED: November 17, 1957
 COMPLETED: December 16, 1957

TOTAL DEPTH: 5065'

INITIAL PRODUCTION: D & A

Date	From	To	Formation
11-17-57	0	118	Clay, blue shale
11-18-57	118	213	Sandy shale
	213	460	Blue shale
11-19-57	460	820	Shale
	820	850	Lime
	850	1225	Shale, sand
	1225	1425	Shale, lime shells
	1425	1475	Lime, anhydrite
11-20-57	1475	1615	Shale, lime
	1615	1670	Shale
	1670	1880	Red bed
	1880	1960	Gyp lime
	1960	1970	Shale
11-21-57	1970	2059	Shale, red bed
	2059	2090	Anhydrite streaks
	2090	2285	Sandy shale
	2285	2469	Shale red
	2469	2480	Lime
11-22-57	2480	2530	Lime, shale
	2530	2660	Shale, lime streaks
	2660	2742	Shale
	2742	2780	Shale, lime shells
11-23-57	2780	2820	Shale, lime streaks
	2820	2835	Shale
	2835	2847	Lime
	2847	2860	Shale
	2860	2995	Shale, lime shells
11-24-57	2995	3070	Shale, lime streaks
	3070	3090	Lime
	3090	3125	Shale, lime
	3125	3128	Lime
	3128	3133	Cherty lime
	3133	3150	Dolomite lime
11-25-57	3150	3193	Lime, shale streaks
	3193	3305	Lime, shale
11-26-57	3305	3399	Shale, lime
	3399	3408	Lime
	3408	3505	Lime, shale
11-27-57	3505	3604	Lime, shale
	3604	3707	Lime
11-28-57	3707	3775	Lime
	3775	3835	Lime shaley
	3835	3866	Lime
11-29-57	3866	3987	Lime
11-30-57	3987	4100	Lime
12-1-57	4100	4163	Lime, shale streaks
	4163	4195	Shaley lime
	4195	4230	Lime, shale
12-2-57	4230	4262	Lime
	4262	4285	Lime, shale streaks
	4285	4304	Lime
	4304	4330	Lime
	4330	4375	Lime, shale streaks
	4375	4382	Lime - DST #1

RECEIVED
 STATE CORPORATION COMMISSION
 JAN 2 1958
 CONSERVATION DIVISION
 Wichita, Kansas

PLUGGING
 FILE SEC 36 T 13 R 34 W
 BOOK PAGE 70 LINE 39

JOHNIE S. CARTER DRILLING CONTRACTOR
 P. O. Box 194
 Fairfield, Illinois

Log of ROSS #1, Logan County, Kansas

12-4-57	4382	4416	Lime
12-5-57	4416	4445	Lime
	4445	4465	Lime, shale, sand streaks
	4465	4470	Lime, shale sand
12-6-57	4470	4503	Lime, shale
	4503	4562	Lime
12-7-57	4562	4630	Lime
12-8-57	4630	4668	Lime, shale
	4668	4705	Lime
	4705	4730	Sand
12-9-57	4730	4745	Sandy lime
	4745	4810	Lime, chert
12-10-57	4810	4830	Chert
12-12-57	4830	4841	Sandy chert
	4841	4845	Lime
12-13-57	4845	4850	Shaley lime
	4850	4936	Lime
12-14-57	4936	5037	Lime
12-15-57	5037	5065	Lime
	5065		Total Depth

I hereby certify the above and foregoing to be a true and correct copy of the Log on the Ross #1, located in the SE SE SE of Section 36, Township 13 South, Range 34 West, Logan County, Kansas.

[Signature]
 J. S. Carter

Subscribed and sworn to before me this 18th day of December, 1957.

My Commission Expires:
March 22, 1959

[Signature]
 Notary Public, Commissioned & residing in Richland County, Acting in Wayne County, Ill.

RECORDED
 INDEXED
 NOV 20 1958
 LOGAN COUNTY, KANSAS

PLUGGING
 SEC 36 T 13 R 34W
 BOX 10 39