


STATE OF KANSAS  
 STATE CORPORATION COMMISSION  
 Give All Information Completely  
 Make Required Affidavit  
 Mail or Deliver Report to:  
 Conservation Division  
 State Corporation Commission  
 212 North Market, Insurance Bldg.  
 Wichita, Kansas

15-109-00041-00-00

WELL PLUGGING RECORD

Logan County, Sec. 11 Twp. 13S Rge. 36 (W)

Location as "NE/CNW/SW" or footage from lines C SW NE  
 Lease Owner Glenn W. Peel Drilling Co.  
 Lease Name Plummer Well No. 1  
 Office Address R. R. #3, Box 144B, Wichita 20, Kansas  
 Character of Well (completed as Oil, Gas or Dry Hole) Dry Hole  
 Date well completed 1-20 19 61  
 Application for plugging filed 1-20 19 61  
 Application for plugging approved 1-20 19 61  
 Plugging commenced 1-20 19 61  
 Plugging completed 1-20 19 61  
 Reason for abandonment of well or producing formation Dry Hole

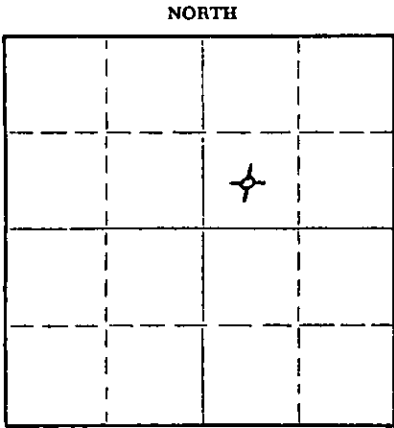

Locate well correctly on above Section Plat

If a producing well is abandoned, date of last production 19  
 Was permission obtained from the Conservation Division or its agents before plugging was commenced? Yes

Name of Conservation Agent who supervised plugging of this well Gilbert P. Leiker  
 Producing formation \_\_\_\_\_ Depth to top \_\_\_\_\_ Bottom \_\_\_\_\_ Total Depth of Well 4605 Feet  
 Show depth and thickness of all water, oil and gas formations.

OIL, GAS OR WATER RECORDS

CASING RECORD

FORMATION	CONTENT	FROM	TO	SIZE	PUT IN	PULLED OUT
		0	165'	8 5/8"	165'	None

Describe in detail the manner in which the well was plugged, indicating where the mud fluid was placed and the method or methods used in introducing it into the hole. If cement or other plugs were used, state the character of same and depth placed, from \_\_\_\_\_ feet to \_\_\_\_\_ feet for each plug set.

From 4605' to 161 1/2' - Heavy Rotary Mud  
 " 161 1/2' to 160' - Wooden plug  
 " 160' to 98' - 20 sacks cement & 1 sack hulls  
 " 98' to 41 1/2' - Heavy Rotary Mud  
 " 41 1/2' to 40' - Wooden Plug  
 " 40' to 6' - 10 sacks cement & 1/2 sack hulls  
 " 6' to Surface - Cellar

01-30-61

(If additional description is necessary, use BACK of this sheet)

Name of Plugging Contractor \_\_\_\_\_  
 Address \_\_\_\_\_

STATE OF KANSAS, COUNTY OF SEDGWICK, ss.  
 William Herbert (employee of owner) or (owner or operator) of the above-described well, being first duly sworn on oath, says: That I have knowledge of the facts, statements, and matters herein contained and the log of the above-described well as filed and that the same are true and correct. So help me God.

(Signature) William Herbert  
 R. R. #3, Box 144B, Wichita 20, Kansas  
 (Address)

SUBSCRIBED AND SWORN TO before me this 27th day of January, 19 61

My commission expires March 4, 1962 William M. Herbert Notary Public.



15-109-00041-00-00

DRILLER'S LOG

Company: Glenn W. Peel Drilling Co.

Location: C SW NE  
Sec. 11, Twp. 13S, Rge. 36W

Farm: Plummer Well No. 1

County: Logan,  
Kansas

Total Depth: 4605'

Comm.: 1-5-61 Comp.: 1-20-61

Elevation:

Contractor: Glenn W. Peel Drilling Co.

Casing: 8 5/8" @ 165' cem.

Production: Dry

Figures below indicate bottom of formations

Surface clay	0 -	15'
Shale w/sand streaks		70
Shale		1460
Shale & shells		1575
Anhydrite		1608
Shale & shells		1625
Shale		1760
Anhydrite		1785
Shale		2035
Anhydrite		2065
Shale		2370
Anhydrite		2395
Shale		2495
Shale & shells		2645
Shale		2805
Shale & Lime		2915
Shale w/lime streaks		3060
Shale & lime		3190
Lime		3425
Lime w/shale streaks		3515
Lime		3605
Lime & shale		3685
Lime		4465
Lime & chart		4495
Lime & sand		4535
Lime		4585
Mississippi lime		4605
Total Depth		4605

This is to certify that the above information is to the best of my knowledge true and correct.

GLENN W. PEEL DRILLING COMPANY

BY: *Glenn W. Peel*

SUBSCRIBED AND SWORN TO before me this 27<sup>th</sup> day of January, 1961.

My commission expires March 4, 1962.

*Marion M. Herbst*  
Notary Public