


STATE OF KANSAS
STATE CORPORATION COMMISSION

WELL PLUGGING RECORD

Give All Information Completely
Make Required Affidavit
Mail or Deliver Report to
Conservation Division
State Corporation Comm.
245 North Water
Wichita, KS 67202

Logan County, Sec. 21 Twp. 13S Rge. 36 XE/W
Location as "NE/CNW/SW" or footage from lines
330' FEL - 1650' FSL
Lease Owner Mark Berry, Winona, Kans. 67764
Lease Name M. Berry Well No. 1
Office Address Box 2420, Tulsa, OK 74102
Character of Well (Completed as Oil, Gas or Dry Hole)
Dry Hole
Date Well completed 11-6-81 19
Application for plugging filed 11-17-81 19
Application for plugging approved 1-4-82 19
Plugging commenced 1-24-82 19
Plugging completed 1-24-82 19
Reason for abandonment of well or producing formation
Dry
If a producing well is abandoned, date of last production
19

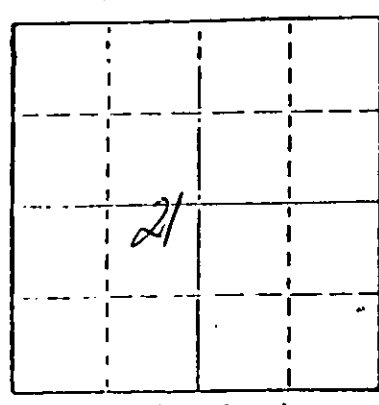

Locate well correctly on above
Section Plot

Was permission obtained from the Conservation Division or
its agents before plugging was commenced? Yes

Name of Conservation Agent who supervised plugging of this well Carl Goodrow
Producing formation _____ Depth to top _____ Bottom _____ Total Depth of Well 5200'
Show depth and thickness of all water, oil and gas formations.

OIL, GAS OR WATER RECORDS

CASING RECORD

FORMATION	CONTENT	FROM	TO	SIZE	PUT IN	PULLED OUT
Topeka		3610	3678	8-5/8"	1535'	-
				5-1/2"	5200'	2610'

Describe in detail the manner in which the well was plugged, indicating where the mud fluid
was placed and the method or methods used in introducing it into the hold. If cement or other
plugs were used, state the character of same and depth placed, from _____ feet to
_____ feet for each plug set.

Well plugged from 5200' to 3760' with heavy mud; from 3760 to
3570' with 30 sx cmt; 3570-1430' with heavy mud; from 1430 to 1115 with
70 sx cmt, from 1115 to 315 with heavy mud; from 315 to 70 below ground
level with 70 sx cmt.

MAR 1 1982
03-01-82
CONSERVATION DIVISION
Wichita, Kansas

(If additional description is necessary, use BACK of this sheet)

Name of Plugging Contractor Sargents Casing Pulling

STATE OF Oklahoma COUNTY OF Tulsa, ss.
B. A. Batson (employee of owner)

of the above-described well, being first duly sworn on oath, says: That I have knowledge of
the facts, statements, and matters herein contained and the log of the above-described well
as filed and that the same are true and correct. So help me God.

(Signature) B.A. Batson B. A. BATSON
Box 2420, Tulsa, Ok 74102
(Address)

SUBSCRIBED AND SWORN TO before me this 25th day of February, 19 82

Elaine Johnson
Notary Public.

My commission expires January 26, 1983

DRILLER'S LOG

15-109-20189-00-00

COMPANY: Texaco, Inc.

SEC. 21 T. 13S R. 36W

WELL NAME: Berry #1

LOC. 330' FEL & 1650' FSL

RIG NO. #11

COUNTY: Logan

TOTAL DEPTH 5200'

ELEVATION

COMMENCED: 10-3-81

COMPLETED: 10-16-81

CONTRACTOR: Rains & Williamson Oil Co., Inc.

CASING RECORD:

SURFACE: 8 5/8" @ 1535' w/650 sx. 35/65 poz., 6% gel, 3% cc., 1/4# D29 and 200 sx. Class H, 3% cc.

PRODUCTION: 5 1/2" @ 5200' w/250 sx. 50/50 poz., 10% salt, 12 1/2# gilsonite and 225 sx. 50/50 poz., 10% salt, 12 1/2# gilsonite

LOG

(Figures Indicate Bottom of Formations)

Shale	1535
Sand	2052
Shale & Lime	3279
Lime	5200
<u>ROTARY TOTAL DEPTH</u>	<u>5200</u>

STATE OF Kansas)


COUNTY OF Sedgwick)

SS:

I, Wilson Rains, President of Rains & Williamson Oil Co., Inc. upon oath state that the above and foregoing is a true and correct copy of the log of the Berry #1 well.

Wilson Rains
Wilson Rains

RECEIVED
STATE OF KANSAS
NOV 23 1981
CONSERVATION DIVISION
Wichita Kansas

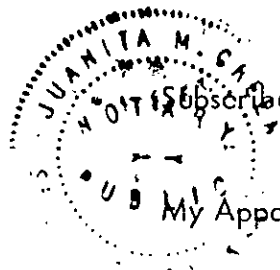

Subscribed and sworn to before me this 21 day of October, 1981.

My Appointment Expires:
10-4-83

Juanita M. Green
Juanita M. Green