

STATE OF KANSAS
STATE CORPORATION COMMISSION

Give All Information Completely
Make Required Affidavit
Mail or Deliver Report to:
Conservation Division
State Corporation Commission
800 Birting Building
Wichita, Kansas

15-109-00009-00-06
WELL PLUGGING RECORD

Logan County, Sec. 28 Twp. 13 Rge. 36 (E) (W) X

Location as "NE/CNW&SW" or footage from lines SE SE SE

Lease Owner Virginia Drilling Co Inc.

Lease Name Hanson Well No. 1

Office Address 712 Brown Bldg-Wichita 2, Kansas

Character of Well (completed as Oil, Gas or Dry Hole) D H

Date well completed 6-8-58 19

Application for plugging filed " 19

Application for plugging approved " 19


Plugging commenced 6-9-58 19

Plugging completed " 19

Reason for abandonment of well or producing formation

If a producing well is abandoned, date of last production 19

Was permission obtained from the Conservation Division or its agents before plugging was commenced? yes

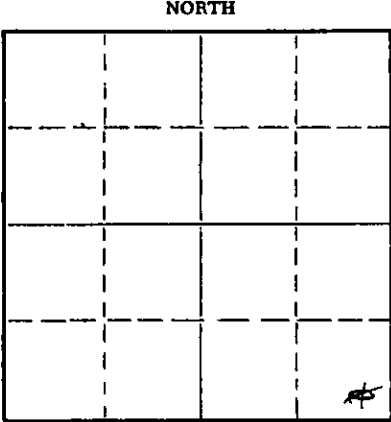

Locate well correctly on above Section Plat

Name of Conservation Agent who supervised plugging of this well Gilbert Leiker
Producing formation _____ Depth to top _____ Bottom _____ Total Depth of Well 4793 Feet

Show depth and thickness of all water, oil and gas formations.

OIL, GAS OR WATER RECORDS

CASING RECORD

FORMATION	CONTENT	FROM	TO	SIZE	PUT IN	PULLED OUT
		0	280	8 5/8	190	none

Describe in detail the manner in which the well was plugged, indicating where the mud fluid was placed and the method or methods used in introducing it into the hole. If cement or other plugs were used, state the character of same and depth placed, from _____ feet to _____ feet for each plug set.

Mudded to 185 ft - set plug w/ 15 sx cement 1/4 sx hulls thru drl pipe

Mudded to 40 ft - set plug w/ 10 sx cement 1/4 sx hulls

(If additional description is necessary, use BACK of this sheet)

Name of Plugging Contractor Virginia Drlg Co Inc
Address 712 Brown Bldg-Wichita 2, Kansas

STATE OF Kansas, COUNTY OF Sedgewick, ss.
S. A. Murphy (employee of owner) or (owner or operator) of the above-described well, being first duly sworn on oath, says: That I have knowledge of the facts, statements, and matters herein contained and the log of the above-described well as filed and that the same are true and correct. So help me God.

(Signature) *S. A. Murphy*
712 Brown Bldg-Wichita 2, Kansas (Address)

SUBSCRIBED AND SWORN TO before me this 26th day of June 19 58

My commission expires Febr. 5, 1961

Marlee E. Hart
Notary Public.

JUN 27 1958
66-27-58
WICHITA, KANSAS

PLUGGING
FILE SEC 28 T 13 R 36W
BOOK PAGE 107 LINE 43

15-109-00009-20-60

HANSON #1 - SE SE SE Section 28-13S-36W, Logan County, Kansas
Company - Virginia Drlg Co., Inc.
Contractor - Virginia Drlg Co., Inc.
Commenced - May 20, 1958
Completed - June 9, 1958
Elevation - 3118 DF
Rotary Total Depth - 4793

Set 8-5/8" csg. at 190' w/125 sks.bulk cement
Dry Hole

FORMATION	DEPTH	TOPS:
Sandy Clay	0-140	
Shale	140-280	
Shale-cip	280-715	
Shale	715-1135	
Shale-sand	1135-1210	
Shale-shells	1210-1570	
Shale-shells-pyrite	1570-1795	
Anhydrite	1795-1825	
Shale-shells	1825-2118	Heebner 3869
Shale, red-bed	2118-2465	Toronto 3891
Lime	2465-2490	Lansing 3916
Shale-shells, lime	2490-2575	Marmoton 4306
Lime-shale	2575-3580	Cherokee 4444
Lime	3580-3700	Cherokee Sand 4673-4680
Lime & shale	3700-3830	Mississippi 4688
Lime	3830-3950	
Lime chirtty	3950-4105	
Lime	4105-4645	
Shale & lime	4645-4685	
Lime	4685-4793	

S. A. Murphy
S. A. Murphy

Subscribed and sworn to before me, a Notary Public,
this 18th day of June, 1958.

W. M. ...
Notary Public

My commission expires: Feb. 5, 1961.

RECEIVED
STATE OF KANSAS
JUN 27 1958
CONSERVATION DIVISION
Wichita, Kansas

287 13 3w
107 114 43