


15-109-00029-00-00

WELL PLUGGING RECORD

Give All Information Completely  
Make Required Affidavit  
Mail or Deliver Report to:  
Conservation Division  
State Corporation Commission  
800 Bittling Building  
Wichita, Kansas

Location as "NE/CNW/SW" or footage from lines Logan County, Sec. 23 Twp. 13 Rge. 35 (X) W (W)  
SE SE SE  
Lease Owner Wycoff-Williams Drilling Company  
Lease Name Teague Well No. 1  
Office Address Box 170 Grinnell, Kansas  
Character of Well (completed as Oil, Gas or Dry Hole) Dry Hole  
Date well completed January 3 19 53  
Application for plugging filed January 2 19 53  
Application for plugging approved January 2 19 53  
Plugging commenced January 3 19 53  
Plugging completed January 3 19 53  
Reason for abandonment of well or producing formation No commercial showings of oil or gas were found in the hole.  
If a producing well is abandoned, date of last production ----- 19 --  
Was permission obtained from the Conservation Division or its agents before plugging was commenced? Yes

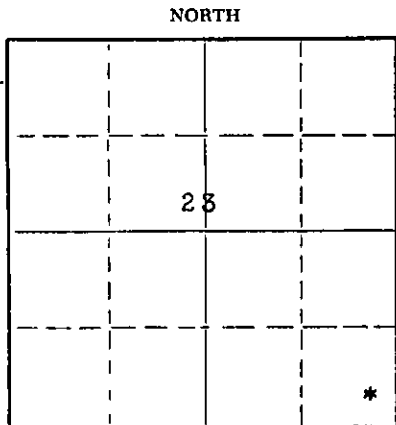

Locate well correctly on above Section Plat

Name of Conservation Agent who supervised plugging of this well Eldon Petty Hays, Kansas  
Producing formation None Depth to top ---- Bottom ----- Total Depth of Well 4604 Feet  
Show depth and thickness of all water, oil and gas formations.

OIL, GAS OR WATER RECORDS

CASING RECORD

FORMATION	CONTENT	FROM	TO	SIZE	PUT IN	PULLED OUT
Unknown	water(?)	50 ft.	60 ft.	8 5/8	120 ft.	None

Describe in detail the manner in which the well was plugged, indicating where the mud fluid was placed and the method or methods used in introducing it into the hole. If cement or other plugs were used, state the character of same and depth placed, from 120 feet to 40 feet for each plug set.

One plug was placed at 120 feet with 15 sacks of cement and then the hole was filled with mud fluid through the use of the rotary mud pump up to 40 feet where 10 more sacks of cement was set.

01-08-53

(If additional description is necessary, use BACK of this sheet)  
Name of Plugging Contractor Wycoff-Williams Drilling Company  
Address Box 170 Grinnell, Kansas

STATE OF Kansas, COUNTY OF Gove, ss.  
Wesley E. Williams (employee of owner) or (owner or operator) of the above-described well, being first duly sworn on oath, says: That I have knowledge of the facts, statements, and matters herein contained and the log of the above-described well as filed and that the same are true and correct. So help me God.

(Signature) Wesley E. Williams  
Box 170 Grinnell, Kansas  
(Address)

SUBSCRIBED AND SWORN TO before me this 5th day of January 19 53  
Harley L. P. Guinness  
Notary Public.

My commission expires June 13th, 1956

**PLUGGING**  
FILE SEC 23 T 13 R 35  
BOOK PAGE 71 LINE 5

15-109-00029-00-00

DRILLER'S WELL LOG

January 5, 1953

Company Wycoff-Williams Drilling Co.

Sec. 23 Twp. 13S Rge. 35W

Farm Teague

Well No. 1 SE SE SE

Total Depth Rotary 4604

County Logan

Comm. 12/13/52 Comp. 1/3/53

State Kansas

Shot or Treated None

Contractor Company Tools

Elevation 2876

Casing: 8 5/8" 120' Cemented

Production Dry

Figures Indicate Bottom of Formations

Surface soil & clay	0-40	Shale & Lime	2600
Shale	120	Red & Blue Shale	2760
Shale & Shells	1340	Lime & Shale	2880
Sand & Shale	1490	Shale & Lime	3020
Sandy Shale & Lime	1550	Lime & Shale	3110
Red Beds	1665	Lime	3135
Anhydrite	1690	Lime & Shale	3205
Shaly Sand & Lime	1920	Shale	3275
Shale & Red Bed	1948	Shale & Lime	3300
Shale & Shells	2115	Lime & Sandy Shale	3346
Anhydrite	2340	Lime & Shale	3415
Shale & Shells	2360	Lime	3500
Anhydrite	2390	Lime	4604
		Total Depth	4604

**PLUGGING**

STATE OF Kansas, COUNTY OF Gove, ss.

FILE SEC-23 T-12 R-252  
BOOK PAGE 71 LINE 5

Wesley E. Williams, (partner) Wycoff-Williams Drilling Co. owner of the above described well, being first duly sworn on oath, says: That I have knowledge of the facts, statements, and matters herein contained and the log of the above-described well as filed and that the same are true and correct. So help me God.

RECEIVED  
STATE CORPORATE COMMISSION  
JAN 8 1953  
CONSERVATION DIVISION  
WICHITA, KANSAS

(Signature) Wesley E. Williams  
Box 170, Grinnell, Kansas  
(Address)

SUBSCRIBED AND SWORN TO before me this 6th day of January, 19 53

My commission expires June 13, 1956

Harley L. McQuinn  
Notary Public