


STATE OF KANSAS
STATE CORPORATION COMMISSION

WELL PLUGGING RECORD

Give All Information Completely
Make Required Affidavit
Mail or Deliver Report to
Conservation Division
State Corporation Comm.
245 North Water
Wichita, KS 67202

Wallace County, Sec. 7 Twp. 13S Rge. 39 xE/W
Location as "NE/CNW/SW" or footage from lines _____

C SW SE
Lease Owner Burnett Corp.
Lease Name Finley Well No. 1
Office Address 450 1st Natl. Bk. Bldg., Amarillo, Tx 79191
Character of Well (Completed as Oil, Gas or Dry Hole) _____

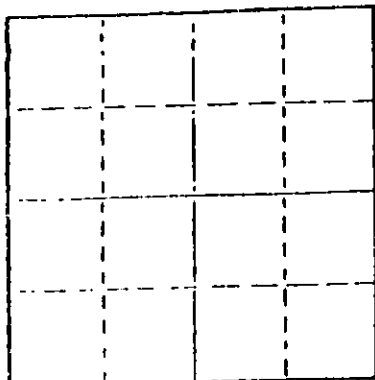

dry hole
Date Well completed 9-30-77 19 77
Application for plugging filed 9-30 19 77
Application for plugging approved 9-30 19 77
Plugging commenced 9-30 19 77
Plugging completed 9-30 19 77

Reason for abandonment of well or producing formation
no commercial quantities of oil or gas encountered
If a producing well is abandoned, date of last production
-- 19

Was permission obtained from the Conservation Division or
its agents before plugging was commenced? yes

Name of Conservation Agent who supervised plugging of this well Leo Massey
Producing formation _____ Depth to top _____ Bottom _____ Total Depth of Well 5160
Show depth and thickness of all water, oil and gas formations.

OIL, GAS OR WATER RECORDS

CASING RECORD

FORMATION	CONTENT	FROM	TO	SIZE	PUT IN	PULLED OUT
surface hole	shale	surf	331	8-5/8	323	none

Describe in detail the manner in which the well was plugged, indicating where the mud fluid was placed and the method or methods used in introducing it into the hold. If cement or other plugs were used, state the character of same and depth placed, from _____ feet to _____ feet for each plug set.

Fluid to 1500', plug, 70 sx
Fluid to 240', plug, 20 sx
Fluid to 40, plug, 10 sx

10-11-1977

(If additional description is necessary, use BACK of this sheet)

Name of Plugging Contractor D N B DRILLING, INC.
515 R. H. Garvey Building
Wichita, Kansas 67202

STATE OF Kansas COUNTY OF Sedgwick, ss.
Ella Priess (employee of owner) or (owner or operator)
of the above-described well, being first duly sworn on oath, says: That I have knowledge of the facts, statements, and matters herein contained and the log of the above-described well as filed and that the same are true and correct. So help me God.

(Signature) Ella Priess

Suite 515, R. H. Garvey Bldg., Wichita, Ks.
(Address) 67202

SUBSCRIBED AND SWORN TO before me this 3rd day of October, 19 77

Dorothy L. Schmidt
Dorothy L. Schmidt Notary Public.

My commission expires 4/30/79

DOROTHY L. SCHMIDT
STATE NOTARY PUBLIC
Sedgwick County, Kansas
My Appt. Exp. April 30, 1979

DRILLERS' LOG

BURNETT CORPORATION
 No. 1 Finley
 C SW SE Sec. 7-13S-39W
 Wallace Co., Kansas

Commenced: 9-21-77
 Completed: 9-30-77

Surface Casing: 323' of 8-5/8"
 cmtd w/265 sx Class H, 3% cc
 9-21-77

FORMATION

DEPTH

Surface Hole	0 - 331
Shale & Sand	331 - 1220
Shale	1220 - 2209
Lime & Shale	2209 - 2440
Lime, Shale & Sand	2440 - 2775
Lime & Shale	2775 - 3050
Lime, Shale & Sand	3050 - 3265
Lime & Shale	3265 - 3990
Lime, Shale & Chert	3990 - 4125
Lime & Shale	4125 - 4388
Lime	4388 - 4613
Lime & Shale	4613 - 4706
Lime	4706 - 4925
Miss. Lime & Chert	4925 - 5004
Lime	5004 - 5260 RTD

I do hereby certify that the foregoing statements are true and correct to the best of my knowledge and belief.

D N B DRILLING, INC.

Ella Priess

Ella Priess

STATE OF KANSAS: ss:

Subscribed and sworn to before me this 3rd day of October, 1977.

DOROTHY L. SCHMIDT
 STATE NOTARY PUBLIC
 Sedgwick County, Kansas
 My Appt. Exp. April 30, 1979

Dorothy L. Schmidt
 Dorothy L. Schmidt, Notary Public