

WELL PLUGGING RECORD

Give Information Completely  
Make Required Affidavit  
Mail or Deliver Report to:  
Conservation Division  
State Corporation Commission  
212 North Market, Insurance Bldg.  
Wichita, Kansas

Wallace County, Sec. 31 Twp. 13S Rge. (E) 39 (W)

Location as "NE/CNW/SW" or footage from lines C NE/4 NE/4

Lease Owner Target Drilling Corporation

Lease Name Fankhauser Well No. 1

Office Address 910 Enterprise Bldg. Tulsa, Oklahoma

Character of Well (completed as Oil, Gas or Dry Hole) Dry Hole

Date well completed 7-9-1961

Application for plugging filed 7-9-1961

Application for plugging approved 7-9-1961


Plugging commenced 7-9-1961

Plugging completed 7-9-1961

Reason for abandonment of well or producing formation No productive horizons encountered

If a producing well is abandoned, date of last production 19

Was permission obtained from the Conservation Division or its agents before plugging was commenced? yes

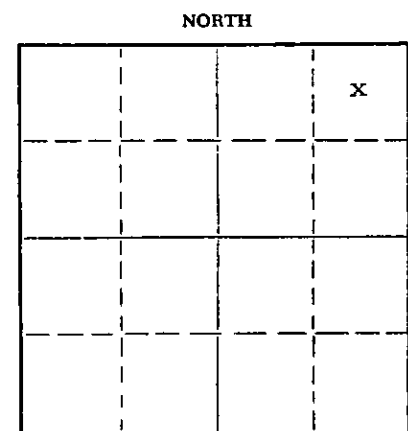

Locate well correctly on above Section Flat

Name of Conservation Agent who supervised plugging of this well Eldon Petty, Hays, Kansas

Producing formation None Depth to top x Bottom x Total Depth of Well 5356 Feet

Show depth and thickness of all water, oil and gas formations.

OIL, GAS OR WATER RECORDS

CASING RECORD

| FORMATION  | CONTENT     | FROM | TD  | SIZE   | PUT IN | PULLED OUT |
|------------|-------------|------|-----|--------|--------|------------|
| Water Sand | Fresh Water | 15'  | 40' | 8 5/8" | 225'   | None       |
|            |             |      |     |        |        |            |
|            |             |      |     |        |        |            |
Describe in detail the manner in which the well was plugged, indicating where the mud fluid was placed and the method or methods used in introducing it into the hole. If cement or other plugs were used, state the character of same and depth placed, from feet to feet for each plug set.

Set cement plug at 220' with twenty sacks cement, filled hole with mud to 40' and set cement plug with ten sacks cement, with two wires attached to plug and extending to surface

RECEIVED  
STATE CORPORATION COMMISSION

JUL 11 1961

CONSERVATION DIVISION  
Wichita, Kansas

07-11-1961

(If additional description is necessary, use BACK of this sheet)  
Name of Plugging Contractor Halliburton Company  
Address McCooke, Nebraska

STATE OF Oklahoma, COUNTY OF Tulsa, ss.

J. W. Garner (employee of owner) or (owner or operator) of the above-described well, being first duly sworn on oath, says: That I have knowledge of the facts, statements, and matters herein contained and the log of the above-described well as filed and that the same are true and correct. So help me God.

(Signature) J. W. Garner  
910 Enterprise Building  
(Address)

SUBSCRIBED AND SWORN TO before me this 10 day of July, 1961

My commission expires 3-24-1965  
3-24 Betty J. Cunningham Notary Public.

TARGET DRILLING CORPORATION  
No 1 Fankhauser  
C NE/4 NE/4 31-13S-39W  
Wallace County, Kansas

DRILLERS SAMPLE DESCRIPTION

|            |                  |
|------------|------------------|
| 0-360      | Shale and Shales |
| 360-950    | Shale Sand       |
| 950-1211   | ND               |
| 1211 -1539 | Shale and Lime   |
| 1539-1610  | Sand             |
| 1610-1712  | Shale and Sand   |
| 1712-1940  | Shale and Lime   |
| 1940-1980  | Lime             |
| 1980-2088  | Lime and Shale   |
| 2088-2568  | Lime and Redbed  |
| 2568-2740  | Shale and Lime   |
| 2740-3319  | Redbed and Lime  |
| 3319-3907  | Lime             |
| 3907-3974  | Lime and Shale   |
| 3974-4359  | Lime             |
| 4359-4454  | Lime             |
| 4454-4489  | Lime             |
| 4489-4535  | Lime             |
| 4535-4609  | Lime             |
| 4609-4637  | Lime             |
| 4637-4678  | Lime             |
| 4678-4700  | Lime             |
| 4700-4795  | Lime             |
| 4795-4812  | Lime             |
| 4812-4866  | Sand and Lime    |
| 4866-4882  | Lime             |
| 4882-4913  | Lime and Shale   |
| 4913-4966  | Lime             |
| 4966-4999  | Lime and Shale   |
| 4999-5095  | Lime             |
| 5095-5100  | Chert            |
| 5100-5117  | Chert            |
| 5117-5356  | Lime             |

RECEIVED  
STATE CORPORATION COMMISSION

JUL 11 1961

CONSERVATION DIVISION  
Wichita, Kansas

07-11-1961

*J. W. Garner*  
\_\_\_\_\_  
J. W. Garner

State of Oklahoma )  
County of Tulsa )

Subscribed and sworn to me a Notary Public this 10th  
day of July 1961

*Betty J. Cunningham*  
\_\_\_\_\_  
Notary Public

My Commission expires March 24, 1965