


15-199-20014-00-00

STATE OF KANSAS  
STATE CORPORATION COMMISSION

WELL PLUGGING RECORD

Give All Information Completely  
Make Required Affidavit  
Mail or Deliver Report to  
Conservation Division  
State Corporation Comm.  
245 North Water  
Wichita, KS 67202

Wallace County, Sec. 16 Twp. 13 Rge. 39W E/W  
Location as "NE/CNW $\frac{1}{4}$ SW $\frac{1}{4}$ " or footage from lines  
C SE NW  
Lease Owner Burnett Corporation  
Lease Name Holcomb Well No. 2  
Office Address 328 First National Bank, Amarillo, Tx  
Character of Well (Completed as Oil, Gas or Dry Hole) 29191

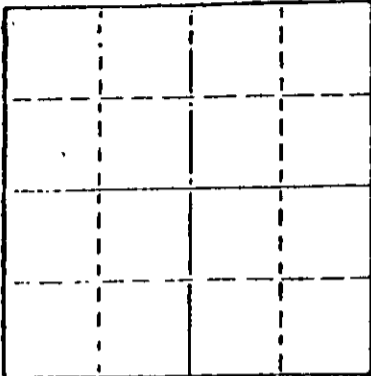

Locate well correctly on above  
Section Plat

Dry Hole  
Date Well completed 4/29/ 19 77  
Application for plugging filed 4/29 19 77  
Application for plugging approved 4/29 19 77  
Plugging commenced 4/29 19 77  
Plugging completed 4/29 19 77  
Reason for abandonment of well or producing formation  
No commercial quantities of oil or gas encountered  
If a producing well is abandoned, date of last production 19

Was permission obtained from the Conservation Division or  
its agents before plugging was commenced? Yes

Name of Conservation Agent who supervised plugging of this well Gilbert Balthazor  
Producing formation \_\_\_\_\_ Depth to top \_\_\_\_\_ Bottom \_\_\_\_\_ Total Depth of Well 4800'  
Show depth and thickness of all water, oil and gas formations.

OIL, GAS OR WATER RECORDS

CASING RECORD

FORMATION	CONTENT	FROM	TO	SIZE	PUT IN	PULLED OUT
Surface Hole	Shale	Surf.	332	8-5/8"	324	none

Describe in detail the manner in which the well was plugged, indicating where the mud fluid  
was placed and the method or methods used in introducing it into the hold. If cement or other  
plugs were used, state the character of same and depth placed, from \_\_\_\_\_ feet to  
\_\_\_\_\_ feet for each plug set.

Fluid to 1350', plug, 70 sx cement  
Fluid to 300', plug, 20 sx cement  
Fluid to 40', plug, 10 sx cement

RECEIVED  
STATE CORPORATION COMMISSION

MAY 04 1977  
05-04-1977  
CONSERVATION DIVISION  
Wichita, Kansas

(If additional description is necessary, use back of this sheet)

Name of Plugging Contractor DNB DRILLING, INC.  
515 R. H. Garvey Building  
Wichita, Kansas 67202


STATE OF KANSAS COUNTY OF \_\_\_\_\_, ss.  
JAMES L. DONELSON (employee of owner) or (owner or operator)  
of the above-described well, being first duly sworn on oath, says: That I have knowledge of  
the facts, statements, and matters herein contained and the log of the above-described well  
as filed and that the same are true and correct. So help me God.

(Signature) James L. Donelson  
515 R. H. Garvey Bldg., Wichita, KS  
(Address) 67202

SUBSCRIBED AND SWORN TO before me this 3rd day of May, 1977

Ella Priess  
Ella Priess Notary Public.

My commission expires 8/25/80

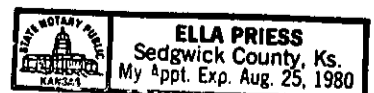

DRILLERS' LOG

15-199-20014-00-00

BURNETT CORPORATION  
No. 2 Holcomb  
C SE NW, Sec. 16-13-39W  
Wallace Co., Kansas

Elev: 3337 G.L.

Commenced: 4/16/77  
Completed: 4/29/77

Surface Casing: 324.65' of  
8-5/8" 20# new casing,  
cemented w/275 sx Class H  
3%cc, 1/4# Flo-seal per sack  
4/17/77

FORMATION

DEPTH

Surface Hole	0	-	332	
Shale & Shells	332	-	720	
Shale	720	-	1730	
Shale & Sand	1730	-	2552	
Anhydrite	2552	-	2582	
Sand & Shale	2582	-	3087	
Lime & Shale	3087	-	3400	
Shale & Lime	3400	-	3525	
Shale	3525	-	3641	
Lime & Shale	3641	-	4390	
Shale	4390	-	4480	
Lime	4480	-	4590	
Lime & Shale	4590	-	4650	
Sand & Shale	4650	-	4785	
Lime & Shale	4785	-	4800	R.T.D.

RECEIVED  
STATE CORPORATION COMMISSION

MAY 04 1977  
05-04-1977  
CONSERVATION DIVISION  
Wichita, Kansas

I do hereby certify that the foregoing statements are true and correct to the best of my knowledge and belief.

D. M. B. DRILLING, INC.

*James L. Donelson*  
JAMES L. DONELSON

STATE OF KANSAS: ss:

Subscribed and sworn to before me this 3rd day of May, 1977.

*Ella Priess*

Ella Priess, Notary Public

