


WELL PLUGGING RECORD

Give All Information Completely  
Make Required Affidavit  
Mail or Deliver Report to:  
Conservation Division  
State Corporation Commission  
800 Bitting Building  
Wichita, Kansas

NORTH

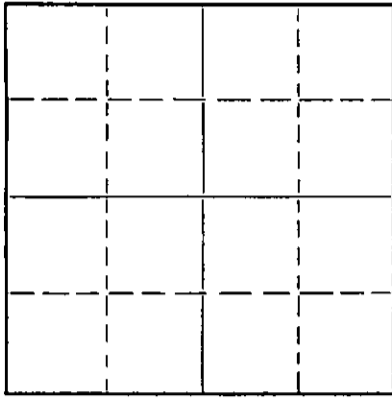

Locate well correctly on above  
Section Flat

Ellis County. Sec. 28 Twp. 14 Rge. (E) 16 (W)  
Location as "NE/CNW $\frac{1}{4}$ SW $\frac{1}{4}$ " or footage from lines SE SE NW $\frac{1}{4}$   
Lease Owner Armer Drilling Company, Inc.  
Lease Name Rajewski Well No. 1  
Office Address 710 Petroleum Bldg., Wichita, Kansas  
Character of Well (completed as Oil, Gas or Dry Hole) dry hole  
Date well completed 4/2 19 50  
Application for plugging filed 4/2 19 50  
Application for plugging approved 4/2 19 50  
Plugging commenced 4/2 19 50  
Plugging completed 4/2 19 50  
Reason for abandonment of well or producing formation dry

If a producing well is abandoned, date of last production 19  
Was permission obtained from the Conservation Division or its agents before plugging was commenced? YES

Name of Conservation Agent who supervised plugging of this well Eldon Petty  
Producing formation Arbuckle Depth to top 3434 Bottom 3475 Total Depth of Well 3475 Feet  
Show depth and thickness of all water, oil and gas formations.

OIL, GAS OR WATER RECORDS

CASING RECORD

Formation	Content	From	To	Size	Put In	Pulled Out
				8 5/8"	125	none

Describe in detail the manner in which the well was plugged, indicating where the mud fluid was placed and the method or methods used in introducing it into the hole. If cement or other plugs were used, state the character of same and depth placed, from feet to feet for each plug set.

Hole mudded with heavy mud from 3475 ft. to 125 ft. and cemented with 15 sacks cement, filled with heavy mud and 10 sacks cement at surface.

04-05-1950

(If additional description is necessary, use BACK of this sheet)

Correspondence regarding this well should be addressed to Armer Drilling Company, Inc.  
Address 710 Petroleum Bldg., Wichita, Kansas

STATE OF Kansas COUNTY OF Sedgwick, ss.  
L. C. Sponenberg (employee of owner) of the above-described well,  
being first duly sworn on oath, says: That I have knowledge of the facts, statements, and matters herein contained and the log of the above-described well as filed and that the same are true and correct. So help me God.

(Signature) *L. C. Sponenberg*  
710 Petroleum Bldg., Wichita 2, Kansas  
(Address)

SUBSCRIBED AND SWORN to before me this 4th day of April, 19 50.

*Hazel Walton*  
Notary Public.

My commission expires Sept. 17, 1951

22-7877-1 4-49-10M  
FILE SEC 28 T 14 N (see)  
BOOK PAGE 146 LINE 9

15-081-00979-00-00

L O G

Company: Armer Drilling Company, Inc.  
Contractor: Armer Drilling Company, Inc.  
Drilling commenced: 3/15/50  
Drilling completed: 4/2/50  
Elevation: 1895 D. F.  
1891 Gr.

Farm: Rajewski - well #1  
Location: SE SE NW $\frac{1}{4}$  Sec. 28-14-16,  
Ellis County, Kansas

Casing record: 8-5/8" set @ 125'  
cemented w/ 75 sacks cement

(figures below indicate bottoms)

Post rock & shale	85
Shale & shells	525
Sand & shale	640
Shale & red bed	875
Red bed	900
Shale, red bed & sand	1010
Anhydrite	1050
Shale & shells	1700
Lime & shale	2086
Sandy lime & shale	2155
Lime & shale, lime sharp	2200
Lime & shale	2940
Lime	2978
Lime & shale	3025
Lime	3135
Lime & shale	3183
Lime	3411
Lime & cherty conglomerate	3467
Lime	3475
Total depth - rotary	3475 D & A

Formation tops: (R. B. measurement)

Heebner	3119
Toronto	3139
Kansas City	3168
Conglomerate	3411
Arbuckle	3434

I hereby certify that this is a true and correct log of the above described well as shown by the drilling reports.

ARMER DRILLING COMPANY, INC.

04-05-1950 By *Carl P. Spurnberg*

STATE OF KANSAS )  
                          ) SS  
COUNTY OF SEDGWICK )

Subscribed and sworn to before me, a notary public, in and for said County and State this 4th day of April, 1950.

*Loyd Waeton*  
Notary Public.

My commission expires Sept. 17, 1950

LOGGING  
FILE SEC 28 T 14 R 16W  
BOOK PAGE 146 LINE 9