

15-051-03902-00-00

STATE OF KANSAS
STATE CORPORATION COMMISSION

WELL PLUGGING RECORD

Give All Information Completely
Make Required Affidavit
Mail or Deliver Report to:
Conservation Division
State Corporation Commission
800 Bitting Building
Wichita, Kansas


OR

FORMATION PLUGGING RECORD

Strike out upper line
when reporting plug-
ging off formations.

Ellis County, Sec. 30 Twp. 14S Rge. (E) 16W
Location as "NE1/4NW1/4SW1/4" or footage from lines... 330' W & 990' S of NE1/4 Corner
Lease Owner... Cities Service Oil Company
Lease Name... Brungardt Well No. 1
Office Address... Bartlesville, Okla.
Character of Well (completed as Oil, Gas or Dry Hole)... Dry Hole
Date well completed... 11-18-45 19
Application for plugging filed... 11-19-45 19
Application for plugging approved... 11-19-45 19
Plugging commenced... 11-19-45 19
Plugging completed... 11-19-45 19
Reason for abandonment of well or producing formation... Dry

NORTH

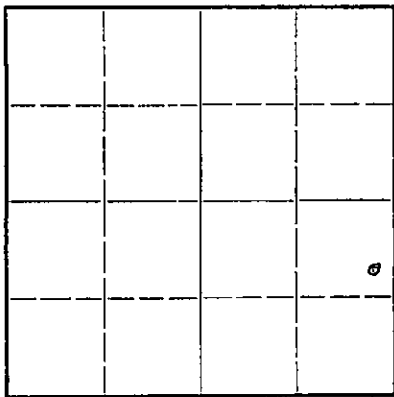

Locate well correctly on above
Section Plat

Name of Conservation Agent who supervised plugging of this well... Herb Kerr
Producing formation... Arbuckle Line Depth to top... 3460' Bottom... Total Depth of Well... 3490 Feet
Show depth and thickness of all water, oil and gas formations.

OIL, GAS OR WATER RECORDS


CASING RECORD

Formation	Content	From	To	Size	Put In	Pulled Out
Arbuckle Line	Dry			8 5/8"	1032'	None
				13"	94'	None

Describe in detail the manner in which the well was plugged, indicating where the mud fluid was placed and the method or methods used in introducing it into the hold. If cement or other plugs were used, state the character of same and depth placed, from... feet to... feet for each plug set.

Filled with mud to 250', dumped 20 sacks cement, mud to 15', dumped 15 sacks cement, mud and dirt to surface.

30 14 16W
34 7

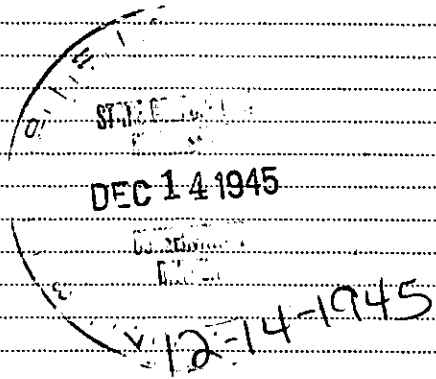

(If additional description is necessary, use BACK of this sheet)

Correspondence regarding this well should be addressed to... R.C. Hauber
Address... Cities Service Oil Company, Great Bend, Kansas

STATE OF KANSAS, COUNTY OF Barton, ss.
J. A. Cleverley (employee of owner) ~~and owner of operation~~ of the above-described well.

being first duly sworn on oath, says: That I have knowledge of the facts, statements, and matters herein contained and the log of the above-described well as filed and that the same are true and correct. So help me God.

(Signature) J. A. Cleverley
Cities Service Oil Company, Russell, Kansas
(Address)

SUBSCRIBED AND SWORN to before me this 28th day of November, 1945

My commission expires Nov 12-1947
W. G. Smith Notary Public.

Company Cities Service Oil Co. Well No. 1 Farm Osage
 Location 990' South and 330' East of 1/4 Corner Sec. 30 T. 14 R. 16W
 Elevation 1915 County Illis State Kansas
 Drig. Comm. October 30, 1945 Contractor Vendor Supply & Development Co.
 Drig. Comp. November 19, 1945 Acid None
 T. O. 490' Initial Prod. Dry - plugged and abandoned (Nov. 17, 1945)

GRINDING RECORD:

13-1/2" 94' cem. 100 sx cem;
 room, top 35' with
 30 sx cem.
 8-5/8" 1012' cem. 400 sx bulk
 cem.

FORMATION LOG:

shale	0-70
sand & shale	95
shale & lime shells	300
sand & shale	300
shale	375
sand, lime & shale	475
sand & shells	490
shale & shells	510
sand & shells	695
shale & shells	735
red bed	840
pyrite, shale & sand	855
shale & shells	980
red bed & shale	1015
anhydrite	1050
lime	1105
sand	1160
salt & red bed	1370
shale & lime	1490
lime & shale	1865
sandy lime & shale	2045
lime & shale	2085
shale & sandy lime	2125
lime & shale	2180
chert & lime	2205
lime	2240
lime & shale	2270
sandy lime & shale	2330
lime & shale	2465
sandy lime & shale	2505
lime & shale	2575
shale & lime	2670
lime & shale	2840

shale & lime	2910
lime & shale	3010
lime	3060
lime & shale	3120
shale & lime	3160
lime & shale	3179
lime	3197
cherty lime & shale	3220
lime	324
cherty lime	3310
lime	3335
lime cherty	3415
lime & shale	3457
lime	390 T. D.

Top Landing	3277'
Top Article	3454'
Construction	36'
Total Depth	390'

Depth Foot (old log):
 1000' OK
 1500' OK
 2000' OK
 2500' OK
 3000' OK

DEC 14 1945

30 14 16W
 34 4

12-14-1945