15-051-03854-00-00


Form CP-4

STATE OF KANSAS
STATE CORPORATION COMMISSION

Give All Information Completely
Make Required Affidavit
Mail or Deliver Report to:
Conservation Division
State Corporation Commission
211 No. Broadway
Wichita, Kansas

WELL PLUGGING RECORD

NORTH

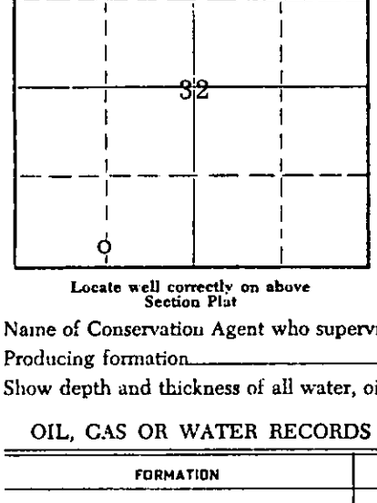

Locate well correctly on above Section Plat

Ellis County. Sec. 29 Twp. 14S Rge. (E) 16 (W)

Location as "NE/CNW¼SW¼" or footage from lines S/2 S/2 SW/4

Lease Owner Clinton Oil Company

Lease Name O. F. Dreiling Well No. 1-X

Office Address 6810 West Highway U.S. 54, Wichita, Kansas

Character of Well (completed as Oil, Gas or Dry Hole) Dry Hole

Date well completed September 1, 1964 19

Application for plugging filed 19

Application for plugging approved 19

Plugging commenced September 1, 1964 19

Plugging completed September 1, 1964 19

Reason for abandonment of well or producing formation Dry

If a producing well is abandoned, date of last production 19

Was permission obtained from the Conservation Division or its agents before plugging was commenced? yes

Name of Conservation Agent who supervised plugging of this well Eldon Petty

Producing formation Depth to top Bottom Total Depth of Well 3480 Feet

Show depth and thickness of all water, oil and gas formations.

OIL, GAS OR WATER RECORDS — CASING RECORD

FORMATION	CONTENT	FROM	TO	SIZE	PUT IN	PULLED OUT

Describe in detail the manner in which the well was plugged, indicating where the mud fluid was placed and the method or methods used in introducing it into the hole. If cement or other plugs were used, state the character of same and depth placed, from feet to feet for each plug set.

Squeezed down surface casing with 125 sacks cement. Job completed September 1, 1964.

RECEIVED
STATE CORPORATION COMMISSION
SEP 4 1964
OCT-04 1964
CONSERVATION DIVISION
Wichita, Kansas

(If additional description is necessary, use BACK of this sheet)

Name of Plugging Contractor Garvey Drilling Company

Address Great Bend, Kansas

STATE OF KANSAS, COUNTY OF Sedgwick, ss.

Earl O. Brandt (employee of owner) or (owner or operator) of the above-described well, being first duly sworn on oath, says: That I have knowledge of the facts, statements, and matters herein contained and the log of the above-described well as filed and that the same are true and correct. So help me God.

(Signature) Earl O. Brandt

6810 West Highway U.S. 54, Wichita, Kansas
(Address)

SUBSCRIBED AND SWORN TO before me this 3rd day of September, 1964

Thelma Keller
Notary Public.

My commission expires July 27, 1967

WELL LOG

15-051-03854-00-00

COMPANY Clinton Oil Company

FARM Dreiling NO. 1 - X

SEC. 29 T. 14S R. 16W

LOC. 1320' E of W line
330' N of S line


TOTAL DEPTH 3480'

COUNTY Ellis

COMM. 8-22-64 COMP. 9-1-64

CONTRACTOR Garvey Drilling Company

CASING 8 5/8" @ 257' w/175 sx

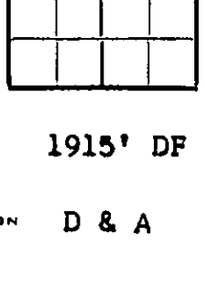

ELEVATION 1915' DF

PRODUCTION D & A

FIGURES INDICATE BOTTOM OF FORMATIONS

75'	Surface Clay
505'	Shale
685'	Sand
1026'	Red Bed and Shale
1068'	Anhydrite
1495'	Shale and Shells
1770'	Shale and Salt
2220'	Lime
2345'	Shale and Lime
2489'	Lime and Shale
2912'	Shale and Lime
2955'	Lime
3014'	Lime and Shale
3436'	Lime
3480'	Arbuckle
3480'	RTD

RECEIVED
STATE CORPORATION COMMISSION

SEP 24 19
09-24-1964
CONSERVATION DIVISION
Wichita, Kansas

State of Kansas }
County of Barton } ss

I, Sam N. Stephens of Garvey Drilling Co.

upon oath state the above and foregoing is a true and correct copy of the log of the Dreiling #1-X well.

Sam N. Stephens

Subscribed and sworn to before me this 18th day of September 19 64

My Commission Expires: September 23rd, 1967

Edward C. Levi
NOTARY PUBLIC