

STATE OF KANSAS
STATE CORPORATION COMMISSION

15-051-22286-00-00

WELL PLUGGING RECORD

Give All Information Completely
Make Required Affidavit
Mail or Deliver Report to
Conservation Division
State Corporation Comm.
245 North Water
Wichita, KS 67202

Ellis County, Sec. 28 Twp. 14 Rge. 16 E/W
Location as "NE/CNW/SW" or footage from lines
NE SE NE


Lease Owner D Oil, Inc. 9394
Lease Name Furthmyer Well No. 2
Office Address P.O. Box 278 Victoria, Ka. 67671
Character of Well (Completed as Oil, Gas or Dry Hole)
Oil

Date Well completed 2-21-81 19
Application for plugging filed 8-17-90 19
Application for plugging approved 8-21-90 19
Plugging commenced 8-31-90 19
Plugging completed 8-31-90 19

Reason for abandonment of well or producing formation
Oil Depleted

If a producing well is abandoned, date of last production
June, 1990 19

Was permission obtained from the Conservation Division or
its agents before plugging was commenced? Yes

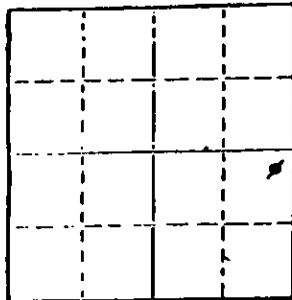

Locate well correctly on above
Section Plat

Name of Conservation Agent who supervised plugging of this well Herb Deines
Producing formation Lansing-K.C., Arb. Depth to top 3254 Bottom 3394 Total Depth of Well 3394
Show depth and thickness of all water, oil and gas formations.

OIL, GAS OR WATER RECORDS

CASING RECORD

| FORMATION | CONTENT | FROM | TO | SIZE | PUT IN | PULLED OUT |
|------------|---------|-------|------|-------|--------|------------|
| Surface | | - 0 - | 197 | 8 5/8 | 197 | - 0 - |
| Production | | - 0 - | 3392 | 4 1/2 | 3392 | - 0 - |
| | | | | | | |
| | | | | | | |

Describe in detail the manner in which the well was plugged, indicating where the mud fluid was placed and the method or methods used in introducing it into the hold. If cement or other plugs were used, state the character of same and depth placed, from feet to feet for each plug set. Perforate 3 shots at 990' and 3 shots at 400'. Ran tubing to 2000' and pump 80 sacks 65/35 Poz., 8% Gel. and 100# hulls. Pulled 1000' tubing and pump 80 sacks 65/35 Poz., 8% Gel and 100# hulls until cement circulates to surface. Pulled tubing and tied into surface pipe and pump 50 sacks of 65/35 Poz., 8% Gel. and 50# hulls. Max. Press. 1000#, SLP 600#. Tied into annulus and pump 10 sacks 65/35 Poz., 8% Gel. Max Press. 450#.

(If additional description is necessary, use BACK of this sheet)

Name of Plugging Contractor B-J Hughes Services

STATE OF Kansas COUNTY OF Ellis, ss.
Alfred J. Dreiling (employee of owner) or (owner or operator)
of the above-described well, being first duly sworn on oath, says: That I have knowledge of the facts, statements, and matters herein contained and the log of the above-described well as filed and that the same are true and correct. So help me God.

(Signature)

[Handwritten Signature]
P.O. Box 278 Victoria, Kansas 67671
(Address)

SUBSCRIBED AND SWORN TO before me this 14th day of SEPTEMBER, 1990

[Handwritten Signature]
Notary Public.

My commission expires



RECEIVED
STATE CORPORATION COMMISSION

SEP 17 1990

SEP 20 1990
09-20-1990
CONSERVATION DIVISION
Wichita, Kansas

DREILING OIL, INC.

Victoria, Kansas 67671

15-051-22286-00-00

WELL LOG

| | | | | |
|-------------|--|---------------|---------|------------------------|
| Company | D-Oil, Inc. Rt. #1 Victoria, KS 67671 | Sec. 28 | Twp. 14 | Ang. 16W |
| Farm | Furthmyer No. 2 | Location NW/4 | | |
| Total Depth | 3392' | County | Ellis | |
| Comm. | 2-16-81 | Comp. | 2-22-81 | Elevation: 1859' K. B. |
| Contractor | Dreiling Oil, Inc. Rt. #1 Victoria, KS 67671 | | 1856' | D. F. |
| | | | 1854' | G. R. |

Casing Record

197' - 8 5/8"
3389' - 4 1/2"

Cement Record

140 sacks cement
125 sacks cement

Production:

Figures Indicate Bottom of Formations

| | | |
|-------|-------|--------------|
| 0' | 70' | Post Rock |
| 70' | 200' | Shale |
| 200' | 605' | Shale |
| 605' | 950' | Shale |
| 950' | 999' | Anhy. |
| 999' | 1150' | Shale |
| 1150' | 1663' | Shale |
| 1663' | 1848' | Shale & Lime |
| 1848' | 2042' | Lime |
| 2042' | 2220' | Lime |
| 2220' | 2490' | Lime |
| 2490' | 2677' | Lime |
| 2677' | 2838' | Lime |
| 2838' | 3021' | Lime |
| 3021' | 3154' | Lime |
| 3154' | 3272' | Lime |
| 3272' | 3384' | Lime |
| 3384' | 3392' | Lime |
| 3392' | T.D. | |

STATE OF KANSAS)
)ss
COUNTY OF ELLIS)

I, Joseph A. Hess, Secretary Treasurer of Dreiling Oil, Inc., upon oath states that the above foregoing is a true and correct copy from the Daily Drilling Report from the Furthmyer #2.

Joseph A. Hess
JOSEPH A. HESS

Subscribed and sworn to before me this 24th day of February, 1981

Patty Dreiling
Patty Dreiling Notary Public

My commission expires: August 30, 1982

