

15-051-23017-00-00


STATE OF KANSAS  
STATE CORPORATION COMMISSION  
200 Colorado Derby Bldg.  
Wichita, Kansas 67202

Form CP-4  
Rev. 12-15-80

WELL PLUGGING RECORD

Give All Information Completely  
Make Required Affidavit

COUNTY ELLIS SEC. 24 TWP. 14 RGE. 16 E/W  
Location as in quarters or footage from lines:  
C S/2 S/2 SW/4

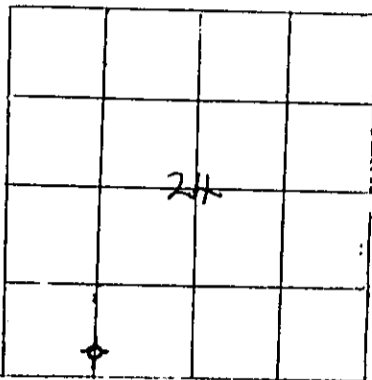

Locate Well  
correctly on above  
Section Platt.

Lease Owner R P NIXON OPERATIONS  
Lease Name ROME Well No. ONE  
Office Address 207 W 12TH, HAYS KS 67601  
Character of Well (Completed as Oil, Gas or Dry Hole): DRY  
Date Well Completed 5-25-82  
Application for plugging filed 5-25-82  
Plugging commenced 5-25-82 @ 8:45 p.m.  
Plugging completed 5-25-82 @ 10:45 p.m.  
Reason for abandonment of well or producing formation

NON-COMMERCIAL

Was permission obtained from the Conservation Division or it's  
Agent's before plugging was commenced? YES

Name of Conservation Agent who supervised plugging of this well GILBERT SCHECK  
Producing formation N/A Depth to top \_\_\_\_\_ bottom T.D. 3410'

Show depth and thickness of all water, oil and gas formations.

OIL, GAS OR WATER RECORDS

Casing Record

Formation	Content	From	To	Size	Put in	Pulled Out
SURFACE				8 5/8"	226'	NONE

Describe in detail the manner in which the well was plugged, indicating where the mud  
fluid was placed and the method or methods used in introducing it into the hold. If cement  
or other plugs were used, state the character of same and depth placed, from \_\_\_\_\_ feet  
to \_\_\_\_\_ feet for each plug set.

RECEIVED

STATE CORPORATION COMMISSION

SEP 15 1982

09-15-1982  
CONSERVATION DIVISION  
Wichita, Kansas

1ST PLUG @ 660' W/70 SX  
2nd PLUG @ 270' W/40 SX  
3RD PLUG @ 40' W/10 SX  
10 SX IN RAT HOLE  
TOTAL 130 SX 50/50 POZ MIX 4% GEL & 3% c.c.

(If additional description is necessary, use BACK of this sheet)

Name of Plugging Contractor JAY-LAN CORPORATION

STATE OF KANSAS COUNTY OF ELLIS, ss.  
DAN A NIXON (employee of owner) or (owner or operator) of the  
above-described well, being first duly sworn on oath, says: That I have knowledge of the  
facts, statements, and matters herein contained and the log of the above-described well as  
filed and that the same are true and correct. So help me God.

(Signature) [Signature]  
207 W 12TH  
(Address)

SUBSCRIBED AND SWORN TO before me this 2ND day of SEPTEMBER, 1982

[Signature]  
Notary Public.

My Commission expires: 7-15-84

MARKED M. STEFAN  
NOTARY PUBLIC  
WICHITA, KANSAS  
7-15-84