


STATE OF KANSAS
 STATE CORPORATION COMMISSION
 Give All Information Completely
 Make Required Affidavit
 Mail or Deliver Report to:
 Conservation Division
 State Corporation Commission
 211 No. Broadway
 Wichita, Kansas

15-051-01227-00-00

WELL PLUGGING RECORD

NORTH

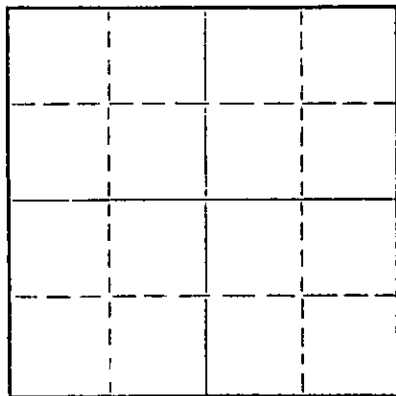

Locate well correctly on above Section Plat

Ellis County, Sec. 20 Twp. 14 Rge. (E) 16(W)
 Location as "NE/CNWKSWK" or footage from lines SW SW SW
 Lease Owner Tomlinson-Kathol, Inc.
 Lease Name Schmidtberger Well No. 1
 Office Address 414 Union Center, Wichita, Kansas
 Character of Well (completed as Oil, Gas or Dry Hole) Dry Hole
 Date well completed 6/5/ 19 58
 Application for plugging filed 6/5/ 19 58
 Application for plugging approved 6/5/ 19 58
 Plugging commenced 6/6/ 19 58
 Plugging completed 6/6/ 19 58
 Reason for abandonment of well or producing formation Dry Hole

If a producing well is abandoned, date of last production 19
 Was permission obtained from the Conservation Division or its agents before plugging was commenced? yes

Name of Conservation Agent who supervised plugging of this well Elden Petty
 Producing formation Depth to top Bottom Total Depth of Well 3485 Feet
 Show depth and thickness of all water, oil and gas formations.

OIL, GAS OR WATER RECORDS

CASING RECORD

FORMATION	CONTENT	FROM	TO	SIZE	PUT IN	PULLED OUT
				8-5/8	248'	None

Describe in detail the manner in which the well was plugged, indicating where the mud fluid was placed and the method or methods used in introducing it into the hole. If cement or other plugs were used, state the character of same and depth placed, from feet to feet for each plug set.

Hole filled with heavy mud to 500' plug @ 500' 20 sacks
 cement plug @ 210 20 sacks cement plug @ 40' 10 sacks cement

07-11-1958

(If additional description is necessary, use BACK of this sheet)
 Name of Plugging Contractor Tomlinson-Kathol, Inc.
 Address 414 Union Center, Wichita, Kansas

STATE OF Kansas COUNTY OF Sedgwick, ss.
 Warren E. Tomlinson (employee of owner) or (owner or operator) of the above-described well, being first duly sworn on oath, says: That I have knowledge of the facts, statements, and matters herein contained and the log of the above-described well as filed and that the same are true and correct. So help me God.

(Signature) Warren E Tomlinson
 414 Union Center (Address)

SUBSCRIBED AND SWORN TO before me this 8th day of July, 19 58

Easter Lamore Notary Public.

My commission expires Jan. 19, 1961

PLUGGING
 FILE SEC 20 T 14 R 16W
 BOOK PAGE 113 21

DRILLERS LOG

TOMLINSON-KATHOL, INC.
1 SCHMIDTBERGER
SW SW SW, SEC. 20-14S-16W
ELLIS COUNTY, KANSAS

Contractor - Tomlinson-Kathol, Inc.

Elevation 1917 KB
Commenced 6/26/58
Completed 7/6/58

<u>From</u>	<u>To</u>	<u>Description</u>	<u>Remarks</u>
0	35	Sand & Gravel	
35	130	Shale	
130	244	Shale & Clay	248' 8-5/8" w/150 sks cement
244	354	Sand & Clay	
354	479	Clay	
479	670	Shale	
760	715	Dakota Sand	
715	850	Red bed	
850	1053	Shale & Sand streaks	
1053	1093	Shale & red bed	
1093	1117	Anhydrite	
1117	1158	Shale	
1158	1540	Shale & Shells	
1540	1745	Shale	
1745	1948	Shale & Lime streaks	
1948	2603	Lime & shale	
2603	2675	Lime	
2675	2918	Lime & shale	
2918	2981	Shale & Lime	
2981	3067	Lime	
3067	3174	Lime & Shale	
3174	3257	Lime	Heebner 3139
3257	3305	Lime & Shale	Toronto 3158
3305	3418	Lime	Lansing 3189
3418	3432	Lime & Shale	Arbuckle 3432
3432	3485	Dolomite	
3485		RTD	D & A

07-11-1958

I certify that to the best of my knowledge and belief, the above represents a true and accurate Driller's Log record of the captioned well.

Warren E. Tomlinson
Warren E. Tomlinson

State of Kansas)
County of Sedgwick)

Subscribed and sworn to before me this 8th day of July, 1958.

Esther Lannon
Notary Public

My Commission expires Jan. 19, 1961

PLUGGING
FILE SEC 20 T 14 R 16W
BOOK PAGE 113 LINE 21