


STATE OF KANSAS  
STATE CORPORATION COMMISSION

Give All Information Completely  
Make Required Affidavit  
Mail or Deliver Report to:  
Conservation Division  
State Corporation Commission  
800 Biting Building  
Wichita, Kansas

NORTH

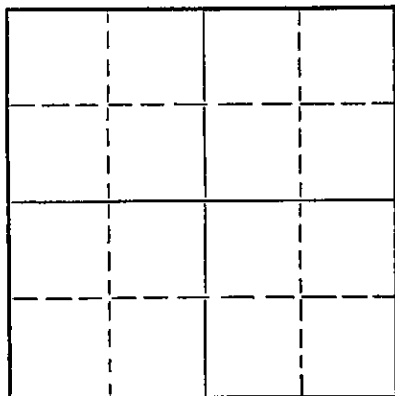

Locate well correctly on above  
Section Flat

15-051-01075-00-00  
WELL PLUGGING RECORD

ELLIS County. Sec. 19 Twp. 14 S Rge. 16 (E) W(W)  
Location as "NE/CNWKSWK" or footage from lines SE SE NW  
Lease Owner. Shelley-Miller Drilling, Inc.  
Lease Name. Linenberger Well No. 1  
Office Address. 205 Miller Building, Wichita, Kansas  
Character of Well (completed as Oil, Gas or Dry Hole) Dry Hole  
Date well completed July 3 19 55  
Application for plugging filed July 3 19 55  
Application for plugging approved July 3 19 55  
Plugging commenced July 3 19 55  
Plugging completed July 3 19 55  
Reason for abandonment of well or producing formation Failure to produce  
in commercial quantities  
If a producing well is abandoned, date of last production 19  
Was permission obtained from the Conservation Division or its agents before plugging was com-  
menced? Yes

Name of Conservation Agent who supervised plugging of this well Eldon Petty  
Producing formation Depth to top Bottom Total Depth of Well 3465 Feet  
Show depth and thickness of all water, oil and gas formations.

OIL, GAS OR WATER RECORDS

CASING RECORD

FORMATION	CONTENT	FROM	TO	SIZE	PUT IN	PULLED OUT
				8 5/8"	169'	

Describe in detail the manner in which the well was plugged, indicating where the mud fluid was placed and the method or methods used  
in introducing it into the hole. If cement or other plugs were used, state the character of same and depth placed, from feet to  
feet for each plug set.

Filled hole with heavy mud 8 5/8" plug and pumped in 80 sacks cement

(If additional description is necessary, use BACK of this sheet)

Name of Plugging Contractor  
Address

STATE OF KANSAS, COUNTY OF SEDGWICK, ss.  
Richard A. Shelley (employee of owner) or (owner or operator) of the above-described  
well, being first duly sworn on oath, says: That I have knowledge of the facts, statements, and matters herein contained and the log of the  
above-described well as filed and that the same are true and correct. So help me God.

(Signature)

205 Miller Building, Wichita, Kansas  
(Address)

SUBSCRIBED AND SWORN TO before me this 3rd day of July, 19 55

My commission expires March 24, 1956

Notary Public.

24-7368-8 3-53-20M

PLUGGING  
FILE SEC 19 T 14 R 16 W  
BOOK PAGE 131 LINE 39

07-07-1955

15-051-01075-00-00

COMPANY: Shelley-Miller Drilling, Inc.  
205 Miller Building  
Wichita, Kansas

Rotary Drilling Commenced: 6-24-55  
Rotary Drilling Completed: 7- 3-55

LOCATION: Linenberger No. 1  
SE SE NW 19-14S-16W  
Ellis County, Kansas

CONTRACTOR: Shelley-Miller Drilling, Inc.  
205 Miller Building  
Wichita, Kansas

CASING RECORD: 8 5/8" 28# Casing Set @ 169 feet, cemented with  
115 sacks cement.

L O G  
(Measurements from top of Rotary Bushing to bottom of formation)

Shale	169
Shale & Shells	560
Sand	835
Red Bed	1,069
Anhydrite	1,105
Shale & Shells	1,320
Shale	1,720
Lime & Shale	1,820
Lime	1,975
Lime & Shale	2,230
Lime	2,315
Lime & Shale	2,530
Shale & Shells	2,890
Lime & Shale	3,070
Lime	3,465 Rotary T. D.

The undersigned, Richard A. Shelley, President of Shelley-Miller Drilling, Inc., hereby certifies in behalf of said company, that the above log is a true and correct log of the formation encountered in drilling the above well as reflected by the Daily Drilling Reports.

SHELLEY-MILLER DRILLING, INC.

By Richard A. Shelley  
President


STATE OF KANSAS )  
COUNTY OF SEDGWICK ) SS

BE IT REMEMBERED, that on this 6th day of July, 1955, before me, the undersigned, a Notary Public, duly commissioned in and for the county and state aforesaid, came Richard A. Shelley, President, and known to me to be the same person who executed the foregoing instrument of writing in behalf of Shelley-Miller Drilling, Inc., as President of said company, and he duly acknowledged the execution of the same for himself and for said company.

IN WITNESS WHEREOF, I have hereunto set my hand and official seal on the day and year last above written.

Leon M. Baker  
Notary Public

My Commission Expires:  
March 24, 1956

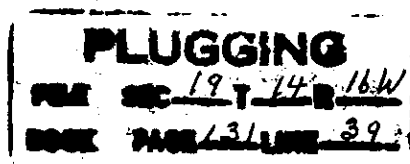

07-07-1955