

CARD MUST BE TYPED

State of Kansas
NOTICE OF INTENTION TO DRILL
(see rules on reverse side)

CARD MUST BE SIGNED

Starting Date: August 21 1984
month day year

API Number 15- 051-23,997-00-00

OPERATOR: License # 5258
Name Messman-Rinehart Corporation
Address 500 Bitting Building
City/State/Zip Wichita, Kansas, 67202
Contact Person J. George Klein
Phone (316) 263-4211

App. NW NE SW Sec 25 Twp 14S S. Rge 16
(location) East West

2310 Ft North from Southeast Corner of Section
3555 Ft West from Southeast Corner of Section
(Note: Locate well on Section Plat on reverse side)

CONTRACTOR: License # 5418
Name Allen Drilling Company
City/State Box 1389, Great Bend, Ks., 67530

Nearest lease or unit boundary line 330 feet.
County Ellis
Lease Name Baumrucker Well# 2

Well Drilled For: Well Class: Type Equipment:
 Oil Swd Infield Mud Rotary
 Gas Inj Pool Ext. Air Rotary
 OWWO Expl Wildcat Cable

Domestic well within 330 feet: yes no
Municipal well within one mile: yes no

If OWWO: old well info as follows:

Operator
Well Name
Comp Date Old Total Depth
Projected Total Depth 3350 feet
Projected Formation at TD Arbuckle
Expected Producing Formations Lansing to Arbuckle

Depth to Bottom of fresh water 100' feet
Lowest usable water formation Dakota
Depth to Bottom of usable water Above 900 450 feet
Surface pipe by Alternate: 1 2
Surface pipe to be set Approx. 900 feet
Conductor pipe if any required feet
Ground surface elevation feet MSI.
This Authorization Expires 2-15-85
Approved By 8-15-84

I certify that we will comply with K.S.A. 55-101, et seq., plus eventually plugging hole to K.C.C. specifications.

Date 8/15/84 Signature of Operator or Agent

MESSMAN-RINEHART CORPORATION
BY: C. B. Rinehart Title
C.B. Rinehart

President

MHC/KONE 8/15/84

08-15-1984

Must be filed with the K.C.C. five (5) days prior to commencing well
This card void if drilling not started within six (6) months of date received by K.C.C.


CONSERVATION DIVISION
Wichita, Kansas

AUG 15 1984

RECEIVED
STATE CORPORATION COMMISSION

Important procedures to follow:

**A Regular Section of Land
1 Mile = 5,280 Ft.**

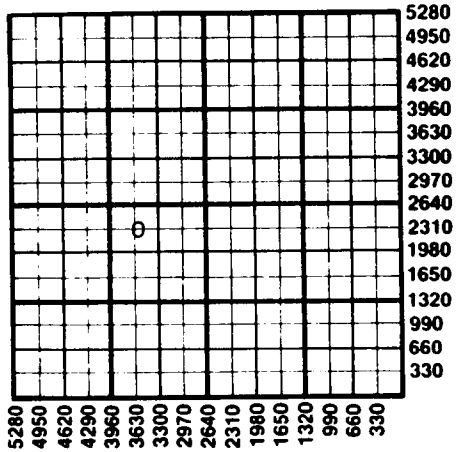

1. Notify District office before setting surface casing.
2. Set surface casing by circulating cement to the top.
3. File completion forms ACO-1 with K.C.C. within 90 days of well completion, following instructions on ACO-1, side 1, and including copies of wireline logs.
4. Notify District office 48 hours prior to old well workover or re-entry.
5. Prior to plugging, prepare a plugging plan, then obtain agreement from the appropriate district office for an approved plugging plan.
6. Submit plugging report (CP-4) to K.C.C. after plugging is completed.
7. Obtain an approved injection docket number before disposing of salt water.
8. Notify K.C.C. within 10 days when injection commences or terminates.
9. If an alternate 2 completion, cement in the production pipe from below any usable water to surface within 120 days of spud date.

State Corporation Commission of Kansas
Conservation Division
200 Colorado Derby Building
Wichita, Kansas 67202
(316) 263-3238