

CARD MUST BE TYPED

State of Kansas
NOTICE OF INTENTION TO DRILL

CARD MUST BE SIGNED

(see rules on reverse side)

Starting Date: 12 1 84
month day year

API Number 15- 051-24,108-00-00

OPERATOR: License # 5252

.SE. SW. NW Sec. 25. Twp 14. S. Rge 16. East
(location) West

Name R. P. Nixon Operations

Address 207 West 12th St.

City/State/Zip Hays, KS. 67601

Contact Person Dan A. Nixon

Phone 913-628-3834

.. 2970 Ft North from Southeast Corner of Section

.. 4290 Ft West from Southeast Corner of Section

(Note: Locate well on Section Plat on reverse side)

CONTRACTOR: License # 5128 Rig Tag. #36

Nearest lease or unit boundary line ... 330 feet.

County Ellis

Lease Name Baumrucker.. B. Well# 2

Name Jay-Lan Corp.

City/State Hays, KS. 67601

Domestic well within 330 feet: yes no

Municipal well within one mile: yes no

Well Drilled For: Well Class: Type Equipment:

Oil Swd Infield Mud Rotary

Gas Inj Pool Ext. Air Rotary

OWWO Expl Wildcat Cable

Depth to Bottom of fresh water ... 37 feet

Lowest usable water formation ... Dakota feet

Depth to Bottom of usable water ... 600 feet

Surface pipe by Alternate: 1 2

Surface pipe to be set ... 200 feet

Conductor pipe if any required feet

Ground surface elevation .. N/A feet MSI.

This Authorization Expires 5-27-85

Approved By 11-27-84 *Rc*

If OWWO: old well info as follows:

Operator

Well Name

Comp Date Old Total Depth

Projected Total Depth ... 3420' feet

Projected Formation at TD ... Arbuckle

Expected Producing Formations ... Conglomerate

I certify that we will comply with K.S.A. 55-101, et seq., plus eventually plugging hole to K.C.C. specifications.

Date 11-26-84 Signature of Operator or Agent


Ronald Hughes Title

Geologist

Must be filed with the K.C.C. five (5) days prior to commencing well
 This card void if drilling not started within six (6) months of date received by K.C.C.

Important procedures to follow :

A Regular Section of Land
1 Mile = 5,280 Ft.

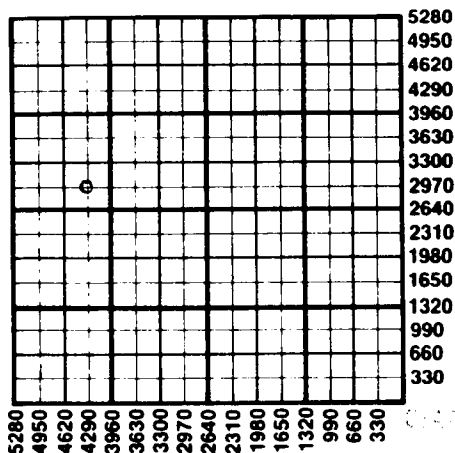

1. Notify District office before setting surface casing.
2. Set surface casing by circulating cement to the top.
3. File completion forms ACO-1 with K.C.C. within 90 days of well completion, following instructions on ACO-1, side 1, and including copies of wireline logs.
4. Notify District office 48 hours prior to old well workover or re-entry.
5. Prior to plugging, prepare a plugging plan, then obtain agreement from the appropriate district office for an approved plugging plan.
6. Submit plugging report (CP-4) to K.C.C. after plugging is completed.
7. Obtain an approved injection docket number before disposing of salt water.
8. Notify K.C.C. within 10 days when injection commences or terminates.
9. If an alternate 2 completion, cement in the production pipe from below any usable water to surface within 120 days of spud date.

STATE CORPORATION COMMISSION OF KANSAS
 CONSERVATION DIVISION

State Corporation Commission of Kansas
 Conservation Division
 200 Colorado Derby Building
 Wichita, Kansas 67202
 (316) 263-3238

NOV 27 1984
 11-27-1984
 STATE CORPORATION COMMISSION OF KANSAS
 WICHITA, KANSAS