

CARD MUST BE TYPED

State of Kansas
NOTICE OF INTENTION TO DRILL

CARD MUST BE SIGNED

(see rules on reverse side)

Starting Date: Oct. 1 1985
month day year

API Number 15- 051-24,328-00-00

OPERATOR: License # 5258
Name Messman-Rinehart Corporation
Address 500 Bitting Building
City/State/Zip Wichita, Kansas, 67202
Contact Person J. George Klein
Phone (316) 263-4211

App. SW SW NE Sec 25 Twp 14S S. Rge 16 East
(location) West

2970 Ft North from Southeast Corner of Section

2310 Ft West from Southeast Corner of Section

(Note: Locate well on Section Plat on reverse side)

CONTRACTOR: License # 5128
Name Jay-Lan Corporation
City/State Hays, Kansas, 67601

Nearest lease or unit boundary line 330 feet.

County Ellis

Lease Name ... Baumrucker "B" Well # 1

Domestic well within 330 feet : yes no

Municipal well within one mile : yes no

Well Drilled For: Well Class: Type Equipment:
 Oil Swd Infield Mud Rotary
 Gas Inj Pool Ext. Air Rotary
 OWWO Expl Wildcat Cable

Depth to Bottom of fresh water 100 feet

Lowest usable water formation Dakota

Depth to Bottom of usable water 450 feet

Surface pipe by Alternate : 1 2

Surface pipe to be set App. 900 feet

Conductor pipe if any required feet

Ground surface elevation feet MSI.

This Authorization Expires 3-25-86

Approved By 9-2585 E

RCA/KATE

If OWWO: old well info as follows:

Operator
Well Name
Comp Date Old Total Depth
Projected Total Depth 3350 feet
Projected Formation at TD Arbuckle
Expected Producing Formations ... Lansing to Arbuckle

I certify that we will comply with K.S.A. 55-101, et seq., plus eventually plugging hole to K.C.C. specifications.

Date Sept. 24, 1985
Signature of Operator or Agent

MESSMAN-RINEHART CORPORATION

By: [Signature] Title President

Must be filed with the K.C.C. five (5) days prior to commencing well
This card void if drilling not started within six (6) months of date received by K.C.C.


RECEIVED
STATE CORPORATION COMMISSION

Important procedures to follow

SEP 25 1985
09-25-1985

CONSERVATION DIVISION
Wichita, Kansas

A Regular Section of Land
1 Mile = 5,280 Ft.

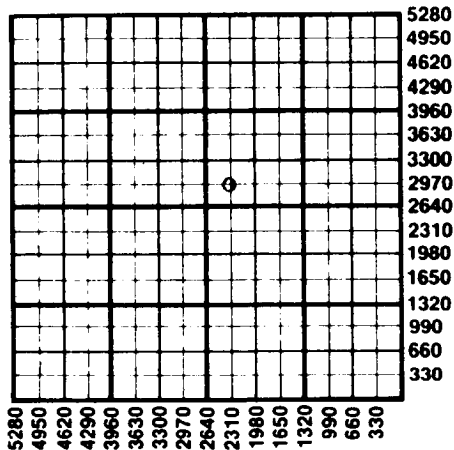

1. Notify District office before setting surface casing.
2. Set surface casing by circulating cement to the top.
3. File completion forms ACO-1 with K.C.C. within 90 days of well completion, following instructions on ACO-1, side 1, and including copies of wireline logs.
4. Notify District office 48 hours prior to old well workover or re-entry.
5. Prior to plugging, prepare a plugging plan, then obtain agreement from the appropriate district office for an approved plugging plan.
6. Submit plugging report (CP-4) to K.C.C. after plugging is completed.
7. Obtain an approved injection docket number before disposing of salt water.
8. Notify K.C.C. within 10 days when injection commences or terminates.
9. If an alternate 2 completion, cement in the production pipe from below any usable water to surface within 120 days of spud date.

State Corporation Commission of Kansas
Conservation Division
200 Colorado Derby Building
Wichita, Kansas 67202
(316) 263-3238