

CARD MUST BE TYPED

State of Kansas
NOTICE OF INTENTION TO DRILL

CARD MUST BE SIGNED

(see rules on reverse side)

Starting Date: 5 23 85
month day year

API Number 15- 051-24,236-00-00

OPERATOR: License # 5252

NW SW NW Sec 25 Twp 14 S Rge 16
(location) East West

Name R P NIXON

Address 207 W 12TH

City/State/Zip HAYS KS 67601

Contact Person DAN A NIXON

Phone 913-628-3834

3630 Ft North from Southeast Corner of Section
4950 Ft West from Southeast Corner of Section
(Note: Locate well on Section Plat on reverse side)

CONTRACTOR: License # 5128 RIG TAG 36

Name JAY-LAN CORPORATION

City/State HAYS KS 67601

Nearest lease or unit boundary line 330 feet

County ELLIS

Lease Name BAUMRUCKER B Well# 3

Domestic well within 330 feet: yes no

Municipal well within one mile: yes no

Well Drilled For: Well Class: Type Equipment:

- Oil Swd Infield Mud Rotary
- Gas Inj Pool Ext. Air Rotary
- OWWO Expl Wildcat Cable

If OWWO: old well info as follows:

Operator

Well Name

Comp Date Old Total Depth

Projected Total Depth 3400 feet

Projected Formation at TD ARBUCKLE

Expected Producing Formations LANSING / KANSAS CITY

Depth to Bottom of fresh water 37 feet
DAKOTA

Lowest usable water formation

Depth to Bottom of usable water 600 feet

Surface pipe by Alternate: 1 2

Surface pipe to be set

Conductor pipe if any required NONE

Ground surface elevation NA feet MSL

This Authorization Expires 11-15-85

Approved By 5-15-85 [Signature]

I certify that we will comply with K.S.A. 55-101, et seq., plus eventually plugging hole to K.C.C. specifications.

Date 5-14-85 Signature of Operator or Agent [Signature]

Title OWNER/OPERATOR

2MHC/KDHE 5-15-85


Must be filed with the K.C.C. five (5) days prior to commencing well
This card void if drilling not started within six (6) months of date received by K.C.C.

RECEIVED
STATE CORPORATION COMMISSION

Important procedures to follow

MAY 15 1985
05-15-1985
CONSERVATION DIVISION
Wichita, Kansas

A Regular Section of Land
1 Mile = 5,280 Ft.

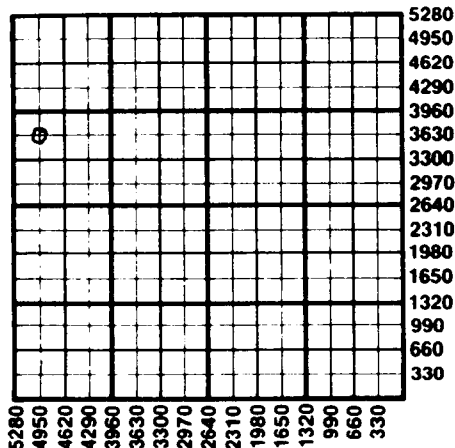

1. Notify District office before setting surface casing.
2. Set surface casing by circulating cement to the top.
3. File completion forms ACO-1 with K.C.C. within 90 days of well completion, following instructions on ACO-1, side 1, and including copies of wireline logs.
4. Notify District office 48 hours prior to old well workover or re-entry.
5. Prior to plugging, prepare a plugging plan, then obtain agreement from the appropriate district office for an approved plugging plan.
6. Submit plugging report (CP-4) to K.C.C. after plugging is completed.
7. Obtain an approved injection docket number before disposing of salt water.
8. Notify K.C.C. within 10 days when injection commences or terminates.
9. If an alternate 2 completion, cement in the production pipe from below any usable water to surface within 120 days of spud date.

State Corporation Commission of Kansas
Conservation Division
200 Colorado Derby Building
Wichita, Kansas 67202
(316) 263-3238