

15-13521603-000


STATE OF KANSAS  
STATE CORPORATION COMMISSION

WELL PLUGGING RECORD

Give All Information Completely  
Make Required Affidavit  
Mail or Deliver Report to  
Conservation Division  
State Corporation Comm.  
245 North Water  
Wichita, KS 67202

Ness County. Sec. 22 Twp. 17S Rge. 24W E/W  
Location as "NE/CNW $\frac{1}{4}$ /SW $\frac{1}{4}$ " or footage from lines  
C SE NE

Lease Owner Reed Oil Company  
Lease Name Margaret Mishler Well No. #1  
Office Address P. O. Box 2, Chanute, Kansas 66720  
Character of Well (Completed as Oil, Gas or Dry Hole) dry hole

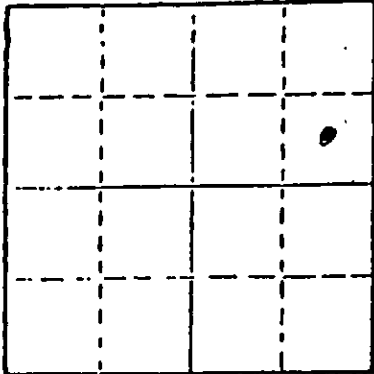

Locate well correctly on above  
Section Plot

Date Well completed April 19, 1979 19  
Application for plugging filed April 19, 1979 19  
Application for plugging approved April 19, 1979 19  
Plugging commenced April 19, 1979 19  
Plugging completed April 19, 1979 19  
Reason for abandonment of well or producing formation dry hole

If a producing well is abandoned, date of last production 19

Was permission obtained from the Conservation Division or its agents before plugging was commenced? yes

Name of Conservation Agent who supervised plugging of this well Leo Massey  
Producing formation \_\_\_\_\_ Depth to top \_\_\_\_\_ Bottom \_\_\_\_\_ Total Depth of Well 4507'  
Show depth and thickness of all water, oil and gas formations.

OIL, GAS OR WATER RECORDS

CASING RECORD

FORMATION	CONTENT	FROM	TO	SIZE	PUT IN	PULLED OUT

Describe in detail the manner in which the well was plugged, indicating where the mud fluid was placed and the method or methods used in introducing it into the hold. If cement or other plugs were used, state the character of same and depth placed, from \_\_\_\_\_ feet to \_\_\_\_\_ feet for each plug set. Hole plugged with 50-50 pozmix, 6% gel, as follows: 70 sacks @ 720', 20 sacks @ 300', hulls and 10 sacks @ 40'. Plugging completed at 9:45 p.m., April 19, 1979.

RECEIVED  
MAY - 1979  
COMMISSION

(If additional description is necessary, use BACK of this sheet)

Name of Plugging Contractor Strata Drilling Company

STATE OF KANSAS COUNTY OF BARTON, ss.  
Charles W. Steincamp (employee of owner) or (owner or operator)

of the above-described well, being first duly sworn on oath, says: That I have knowledge of the facts, statements, and matters herein contained and the log of the above-described well as filed and that the same are true and correct. So help me God.

(Signature) Charles W. Steincamp  
P. O. Box 355, Great Bend, Kansas 67530  
(Address)

SUBSCRIBED AND SWORN TO before me this 27th day of April, 1979

Loneita Barry  
Loneita Barry Notary Public.

My commission expires 3-28-80



1573521603-0000

D R I L L E R S   L O G

#1 M. Mishler.

CASING RECORD:  
9 jts. new 22#  
8-5/8" surface  
casing

COMPANY: Reed Oil Company  
CONTRACTOR: Strata Drilling Company

DESCRIPTION: C SE NE  
Section 22-17S-24W  
Ness County, Kansas

TOTAL ROTARY  
DEPTH: 4507'

COMMENCED: April 12, 1979  
COMPLETED: April 19, 1979

ELEVATION: 2472' KB

D & A

<u>FORMATION</u>	<u>FROM</u>	<u>TO</u>	<u>REMARKS</u>
Surface soil, shale	0	375	Ran 9 jts. new 22# 8-5/8" surface casing; set and cemented at 369' with 215 sacks common cement, 2% gel, 3% C.C. Cement circulated. Plug down 3:45 a.m., April 13, 1979.
Shale, sand, shale	375	1779	
Anhydrite	1779	1812	
Shale	1812	2185	
Shale and Lime	2185	4300	
Lime	4300	4360	
Lime and shale	4360	4507	Ran 2 drill stem tests.
			Hole plugged with 50-50 pozmix, 6% gel, as follows: 70 sacks @ 720', 20 sacks @ 300', hulls and 10 sacks @ 40'. Plugging completed at 9:45 p.m., April 19, 1979.

STATE OF KANSAS )  
                          )ss  
COUNTY OF BARTON)

I certify that this is a true and correct copy of the above log to the best of my knowledge.

STRATA DRILLING COMPANY

Charles W. Steincamp

Sworn to and subscribed before me this 27th day of April, 1979.

My appointment expires 3-28-80.

Loneita Barry  
Loneita Barry, Notary Public

