


STATE OF KANSAS
STATE CORPORATION COMMISSION

WELL PLUGGING RECORD 15-05/ 22/22-00-00

Give All Information Completely
Make Required Affidavit
Mail or Deliver Report to
Conservation Division
State Corporation Comm.
245 North Water
Wichita, KS 67202

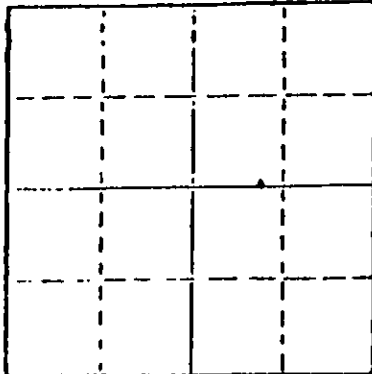

Locate well correctly on above
Section Plot

Ellis County, Sec. 25 Twp. 13 Rge. 20 E/W
Location as "NE/CNW $\frac{1}{4}$ SW $\frac{1}{4}$ " or footage from lines

NE SW SW
Lease Owner J. B. Collins & Jay C. Boyer
Lease Name Orth Well No. 12
Office Address 1007 Cody Ave. Suite A, Hays, KS 67601
Character of Well (Completed as Oil, Gas or Dry Hole) Dry Hole

Date Well completed 10-13 1980
Application for plugging filed 10-13 1980
Application for plugging approved 10-13 1980
Plugging commenced 10-13 1980
Plugging completed 10-13 1980
Reason for abandonment of well or producing formation Dry Hole

If a producing well is abandoned, date of last production 19

Was permission obtained from the Conservation Division or its agents before plugging was commenced? Yes

Name of Conservation Agent who supervised plugging of this well Gilbert Balthazor
Producing formation Depth to top Bottom Total Depth of Well 3860'
Show depth and thickness of all water, oil and gas formations.

OIL, GAS OR WATER RECORDS

CASING RECORD

FORMATION	CONTENT	FROM	TO	SIZE	PUT IN	PULLED OUT
Surface Pipe				8 5/8"	168'	0'

Describe in detail the manner in which the well was plugged, indicating where the mud fluid was placed and the method or methods used in introducing it into the hold. If cement or other plugs were used, state the character of same and depth placed, from feet to feet for each plug set.

1st plug was set @ 800' w/60 sacks cement
2nd plug was set @ 160' w/30 sacks cement
3rd plug was set @ 40' w/10 sacks cement

STATE RECEIVED
OCT 20 1980
CONSERVATION DIVISION
Wichita, Kansas
10-22-80

(If additional description is necessary, use BACK of this sheet)

Name of Plugging Contractor Dreiling Oil, Inc.

STATE OF KANSAS COUNTY OF ELLIS, ss.
I, Joseph A. Hess, Sec. Treas. of Drlg. Contrc. (employee of owner) or (owner or operator) of the above-described well, being first duly sworn on oath, says: That I have knowledge of the facts, statements, and matters herein contained and the log of the above-described well as filed and that the same are true and correct. So help me God.

(Signature) Joseph A. Hess
JOSEPH A. HESS, HAYS, KS 67601

(Address)

SUBSCRIBED AND SWORN TO before me this 17th day of October, 1980

My commission expires August 30, 1982

Patty Dreiling Notary Public.



DREILING OIL, INC.

Victoria, Kansas 67671

J. B. Collins & Jay C. Boy **WELL LOG**
 1007 Cody Ave. - Suite A
 Company Hays, KS 67601
 Farm Orth No. 12
 Total Depth 3860'
 Comm. 10-6-80 Comp. 10-13-80
 Contractor Dreiling Oil, Inc.
 Rt. #1
 Victoria, KS 67671

15.05.22/22.00.00

Sec. 25 Twp. 13 Rng. 20

Location NE SW SW

County Ellis

Elevation: 2205' K. B.

2202' D. F.

2200' G. R.

Casing Record
 168' - 8 5/8"

Cement Record
 130 sacks

Production:
 D & A

Figures Indicate Bottom of Formations

0'	15'	Post Rock
15'	80'	Post Rock
80'	173'	Shale
173'	967'	Shale & Sand
967'	1239'	Shale & Sand
1239'	1498'	Shale
1498'	1535'	Anhy.
1535'	1548'	Anhy.
1548'	2128'	Shale
2128'	2310'	Shale
2310'	2504'	Lime & Shale
2504'	2740'	Shale & Lime
2740'	2975'	Shale & Lime
2975'	3160'	Shale
3160'	3316'	Shale
3316'	3430'	Lime
3430'	3530'	Lime
3530'	3630'	Lime
3630'	3714'	Lime
3714'	3781'	Lime
3781'	3835'	Lime
3835'	3840'	Arbuckle
3840'	3860'	Arbuckle
3860'	T.D.	

STATE OF KANSAS)
)ss
 COUNTY OF ELLIS)

I, Joseph A. Hess, Secretary Treasurer of Dreiling Oil, Inc.,
 upon oath states that the above and foregoing is a true and correct
 copy from the Daily Drilling Report from the Orth #12.


 JOSEPH A. HESS

Subscribed and sworn to before me this 17th day of October, 1980.


 Patty Dreiling Notary Public

My appointment expires: August 30, 1982.



RECEIVED
 STATE CORPORATION COMMISSION
 OCT 22 1980
 CONSERVATION DIVISION
 Wichita, Kansas