

WELL PLUGGING RECORD 15-051-22963-0000

Give All Information Completely  
Make Required Affidavit  
Mail or Deliver Report to  
Conservation Division  
State Corporation Comm.  
200 Colorado Derby Bldg.  
202 W. 1st St.  
Wichita, KS 67202

Ellis County Sec. 25 Twp. 13s Rge. 20  W  
Location as "NE/CNW/SW" or footage from lines \_\_\_\_\_  
SW NE NW

Lease Owner Liberty Enterprises, Inc.

Lease Name Younger Well No. #6

Office Address 308 West Mill Plainville, Ks 67663

Character of Well (Completed as Oil, Gas or Dry Hole) \_\_\_\_\_  
Dry Hole

Date Well completed April 16 19 82

Application for plugging filed April 16 19 82

Application for plugging approved April 16 19 82

Plugging commenced 8:30 P.M. April 16 19 82


Plugging completed 10:00 P.M. April 16 19 82

Reason for abandonment of well or producing formation \_\_\_\_\_  
No Commercial Production

If a producing well is abandoned, date of last production \_\_\_\_\_ 19 \_\_\_\_\_

Was permission obtained from the Conservation Division or its agents before plugging was commenced? Yes

Name of Conservation Agent who supervised plugging of this well Marion Schmidt  
Producing formation \_\_\_\_\_ Depth to top \_\_\_\_\_ Bottom \_\_\_\_\_ Tl. Depth of Well \_\_\_\_\_  
Show depth and thickness of all water, oil and gas formations.

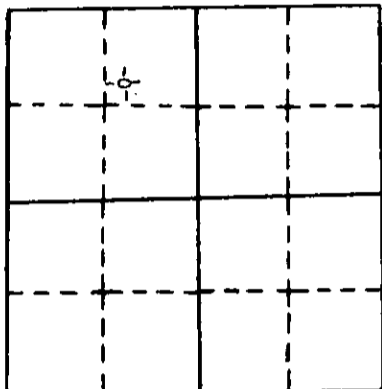

locate well correctly  
on above  
Section Plot

OIL, GAS OR WATER RECORDS

CASING RECORD

FORMATION	CONTENT	FROM	TO	SIZE	PUT IN	PULLED OUT
Surface Casing	common	0'	273'	8 5/8"	273'	0'

Describe in detail the manner in which the well was plugged, indicating where the mud fluid was placed and the method or methods used in introducing it into the hold. If cement or other plugs were used, state the character of same and depth placed, from \_\_\_\_\_ feet to \_\_\_\_\_ feet for each plug set.

Plug #1 820' with 70sxs  
Plug #2 250' with 40sxs  
Plug #3 40' with 10sxs  
10sxs in rathole  
Total-----130sxs 50-50pos 4%gel 3%cc  
P.D. @ 10:00 P.M. 4-16-82

(If additional description is necessary, use BACK of this sheet)


Name of Plugging Contractor Pioneer Drilling Company  
308 West Mill Plainville, KS 67663

STATE OF Kansas COUNTY OF Rooks, ss.

David L. Comeau (employee of owner) or (owner or operator) of above described well, being first duly sworn on oath, says: That I have knowledge of the facts, statements, and matters herein contained and the log of the above described well is filed and that the same are true and correct. So help me God.



(Signature) David L. Comeau  
(Address) 308 West Mill Plainville, Kansas 67663

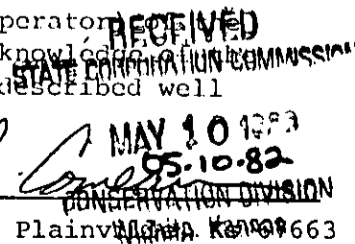

SUBSCRIBED AND SWORN TO before me this 20th day of April, 1982

My commission expires 10-27-85

Betty Janatello  
Notary Public