

RECEIVED
AUG 09 2011

Corrected

For KCC Use: 8-21-2011
Effective Date: 3
 No

KCC WICHITA
KANSAS CORPORATION COMMISSION
OIL & GAS CONSERVATION DIVISION

Form C-1
March 2010
Form must be Typed
Form must be Signed
All blanks must be Filled

NOTICE OF INTENT TO DRILL

Must be approved by KCC five (5) days prior to commencing well
Form KSONA-1, Certification of Compliance with the Kansas Surface Owner Notification Act, MUST be submitted with this form.

Expected Spud Date: 5 / 10 / 11
month day year

Spot Description: NE SW SE SE Sec. 34 Twp. 13 S. R. 25 E W
167 - 361 feet from N / S Line of Section
838 - 746 feet from E / W Line of Section

OPERATOR: License# 34431 ✓
Name: WWEK SAHGAL, Vivek and Namita
Address 1: 20520 W. 95TH ST.
Address 2:
City: LENEXA State: KS Zip: 66220
Contact Person: SUSIE GLAZE
Phone: 913 265 6101

is SECTION: Regular Irregular?
DN (Note: Locate well on the Section Plat on reverse side)

CONTRACTOR: License# 34533 ✓
Name: R.S. GLAZE DRILLING

County: JOHNSON
Lease Name: SAHGAL Well #: 1
Field Name: SAHGAL
Is this a Prorated / Spaced Field? Yes No

Well Drilled For: Oil Gas Enh Rec Storage Disposal Seismic Other
Well Class: Infield Pool Ext. Wildcat Other
Type Equipment: Mud Rotary Air Rotary Cable

Target Formation(s): BARTLESVILLE
Nearest Lease or unit boundary line (in footage): 180 30' N
Ground Surface Elevation: Est 900 feet MSL
Water well within one-quarter mile: Yes No ✓
Public water supply well within one mile: Yes No ✓
Depth to bottom of fresh water: 100
Depth to bottom of usable water: 300
Surface Pipe by Alternate: I II ✓
Length of Surface Pipe Planned to be set: 20
Length of Conductor Pipe (if any): N/A
Projected Total Depth: 900
Formation at Total Depth: BARTLESVILLE

If OWWO - old well information as follows:
Operator: _____
Well Name: _____
Original Completion Date: _____ Original Total Depth: _____

Water Source for Drilling Operations:
 Well Farm Pond Other: _____
DWR Permit #: _____

Directional, Deviated or Horizontal wellbore? Yes No
Approx. true vertical depth: _____
Bottom Hole Location: _____
KCC DKT #: _____

(Note: Apply for Permit with DWR)
Will Cores be taken? Yes No ✓
If Yes, proposed zone: _____

* Residential Gas Well

AFFIDAVIT

The undersigned hereby affirms that the drilling, completion and eventual plugging of this well will comply with K.S.A. 65 et. seq.
It is agreed that the following minimum requirements will be met:

1. Notify the appropriate district office prior to spudding of well;
2. A copy of the approved notice of intent to drill shall be posted on each drilling rig;
3. The minimum amount of surface pipe as specified below shall be set by circulating cement to the top; in all cases surface pipe shall be set through all unconsolidated materials plus a minimum of 20 feet into the underlying formation.
4. If the well is dry hole, an agreement between the operator and the district office on plug length and placement is necessary prior to plugging;
5. The appropriate district office will be notified before well is either plugged or production casing is cemented in;
6. If an ALTERNATE II COMPLETION, production pipe shall be cemented from below any usable water to surface within 120 DAYS of spud date. Or pursuant to Appendix "B" - Eastern Kansas surface casing order #133,891-C, which applies to the KCC District 3 area, alternate II cementing must be completed within 30 days of the spud date or the well shall be plugged. In all cases, NOTIFY district office prior to any cementing.

I hereby certify that the statements made herein are true and to the best of my knowledge and belief.

Date: 8/8/11 Signature of Operator or Agent: _____ Title: Agent

For KCC Use ONLY
API # 15 - 091-23548-0000
Conductor pipe required None feet
Minimum surface pipe required 20 feet per ALT. I II
Approved by: RWG 8-16-2011
This authorization expires: 8-16-2012
(This authorization void if drilling not started within 12 months of approval date.)
Spud date: _____ Agent: _____

Remember to:

- File Certification of Compliance with the Kansas Surface Owner Notification Act (KSONA-1) with Intent to Drill;
- File Drill Pit Application (form CDP-1) with Intent to Drill;
- File Completion Form ACO-1 within 120 days of spud date;
- File acreage attribution plat according to field proration orders;
- Notify appropriate district office 48 hours prior to workover or re-entry;
- Submit plugging report (CP-4) after plugging is completed (within 60 days);
- Obtain written approval before disposing or injecting salt water.
- If well will not be drilled or permit has expired (See: authorized expiration date) please check the box below and return to the address below.

Well will not be drilled or Permit Expired Date: _____
Signature of Operator or Agent: _____

Mail to: KCC - Conservation Division,
130 S. Market - Room 2078, Wichita, Kansas 67202

34
13
25
 E
 W

RECEIVED
AUG 09 2011
KCC WICHITA

Slide Two

For KCC Use ONLY
API # 15 - 091-23548-0000

~~CORRECTED~~

IN ALL CASES PLOT THE INTENDED WELL ON THE PLAT BELOW

In all cases, please fully complete this side of the form. Include items 1 through 5 at the bottom of this page.

Operator: VIVEK SAHGAL
Lease: SAHGAL
Well Number: 1
Field: SAGHAL
Number of Acres attributable to well:
QTR/QTR/QTR/QTR of acreage: NE - SW - SE - SE


Location of Well: County: JOHNSON
197 361 feet from N / S Line of Section
828 746 feet from E / W Line of Section
Sec. 34 Twp. 13 S. R. 25 E W

Is Section: Regular or Irregular

If Section is irregular, locate well from nearest corner boundary.
Section corner used: NE NW SE SW


PLAT

Show location of the well. Show footage to the nearest lease or unit boundary line. Show the predicted locations of lease roads, tank batteries, pipelines and electrical lines, as required by the Kansas Surface Owner Notice Act (House Bill 2032). You may attach a separate plat if desired.

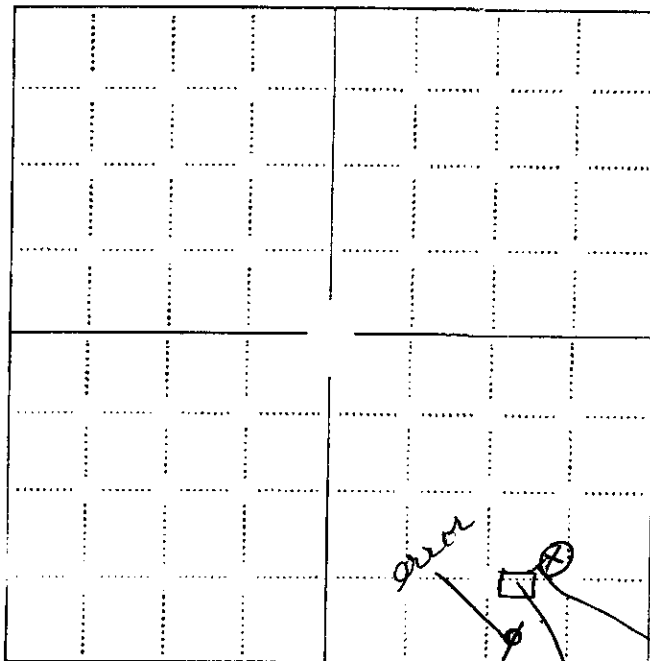

LEGEND

- Well Location
- Tank Battery Location
- Pipeline Location
- Electric Line Location
- Lease Road Location

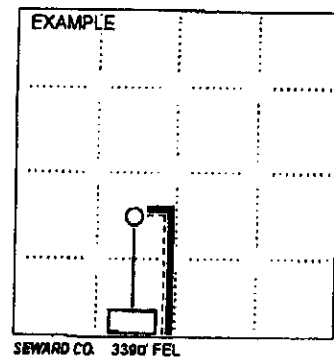

NOTE: In all cases locate the spot of the proposed drilling location.

In plotting the proposed location of the well, you must show:

1. The manner in which you are using the depicted plat by identifying section lines, i.e. 1 section, 1 section with 8 surrounding sections, 4 sections, etc.
2. The distance of the proposed drilling location from the south / north and east / west outside section lines.
3. The distance to the nearest lease or unit boundary line (in footage).
4. If proposed location is located within a prorated or spaced field a certificate of acreage attribution plat must be attached: (CO-7 for oil wells; CG-8 for gas wells).
5. The predicted locations of lease roads, tank batteries, pipelines, and electrical lines.

UPDATED

15091-23548-00-00

RECEIVED
AUG 09 2011

KANSAS CORPORATION COMMISSION
OIL & GAS CONSERVATION DIVISION **KCC WICHITA**

Form KSONA-1
July 2010
Form Must Be Typed
Form must be Signed
All blanks must be Filled

**CERTIFICATION OF COMPLIANCE WITH THE
KANSAS SURFACE OWNER NOTIFICATION ACT**

This form must be submitted with all Forms C-1 (Notice of Intent to Drill); CB-1 (Cathodic Protection Borehole Intent); T-1 (Request for Change of Operator Transfer of Injection or Surface Pit Permit); and CP-1 (Well Plugging Application). Any such form submitted without an accompanying Form KSONA-1 will be returned.

Select the corresponding form being filed: C-1 (Intent) CB-1 (Cathodic Protection Borehole Intent) T-1 (Transfer) CP-1 (Plugging Application)

OPERATOR: License # 34431
Name VIVEK SAHGAL
Address 1: 20520 W. 95TH ST.
Address 2: _____
City: LENEXA State: KS Zip: 66220 + _____
Contact Person: SUSIE GLAZE
Phone: (913) 269 6101 Fax: (_____) _____
Email Address: glazedrilling@yahoo.com

Well Location: NE SW SE Sec. 34 Twp. 13 S. R. 25 East West
County: JOHNSON
Lease Name: SAHGAL Well #: 1

If filing a Form T-1 for multiple wells on a lease, enter the legal description of the lease below:

Surface Owner Information:

Name: VIVEK SAHGAL
Address 1: 20520 W. 95TH ST.
Address 2: _____
City: LENEXA State: KS Zip: 66220 + _____

When filing a Form T-1 involving multiple surface owners, attach an additional sheet listing all of the information to the left for each surface owner. Surface owner information can be found in the records of the register of deeds for the county, and in the real estate property tax records of the county treasurer.

If this form is being submitted with a Form C-1 (Intent) or CB-1 (Cathodic Protection Borehole Intent), you must supply the surface owners and the KCC with a plat showing the predicted locations of lease roads, tank batteries, pipelines, and electrical lines. The locations shown on the plat are preliminary non-binding estimates. The locations may be entered on the Form C-1 plat, Form CB-1 plat, or a separate plat may be submitted.

Select one of the following:

- I certify that, pursuant to the Kansas Surface Owner Notice Act (House Bill 2032), I have provided the following to the surface owner(s) of the land upon which the subject well is or will be located: 1) a copy of the Form C-1, Form CB-1, Form T-1, or Form CP-1 that I am filing in connection with this form; 2) if the form being filed is a Form C-1 or Form CB-1, the plat(s) required by this form; and 3) my operator name, address, phone number, fax, and email address.
- I have not provided this information to the surface owner(s). I acknowledge that, because I have not provided this information, the KCC will be required to send this information to the surface owner(s). To mitigate the additional cost of the KCC performing this task, I acknowledge that I am being charged a \$30.00 handling fee, payable to the KCC, which is enclosed with this form.

If choosing the second option, submit payment of the \$30.00 handling fee with this form. If the fee is not received with this form, the KSONA-1 form and the associated Form C-1, Form CB-1, Form T-1, or Form CP-1 will be returned.

I hereby certify that the statements made herein are true and correct to the best of my knowledge and belief.

Date: 8/2/11 Signature of Operator or Agent: [Signature] Title: Agent

CORRECTIONS

RECEIVED
AUG 09 2011

KANSAS CORPORATION COMMISSION
OIL & GAS CONSERVATION DIVISION
KCC WICHITA
Form CDP-1
May 2010
Form must be Typed
APPLICATION FOR SURFACE PIT

Submit in Duplicate

| | | | |
|---|--|---|--|
| Operator Name: VIVEK SAHGAL | | License Number: 34431 | |
| Operator Address: 20520 W. 95TH ST. | | LENEXA KS. 66220 | |
| Contact Person: SUSIE GLAZE | | Phone Number: 913 269 6101 | |
| Lease No. & Well No. SAHGAL 1 | | Pit Location (QQQQ): NE-SW-SE-SE | |
| Type of Pit: <input type="checkbox"/> Emergency Pit <input type="checkbox"/> Burn Pit <input type="checkbox"/> Settling Pit <input checked="" type="checkbox"/> Drilling Pit <input type="checkbox"/> Workover Pit <input type="checkbox"/> Haul-Off Pit <small>(If WVP Supply API No. or Year Drilled)</small> | | Pit is: <input checked="" type="checkbox"/> Proposed <input type="checkbox"/> Existing If Existing, date constructed: Pit capacity: _____ (bbls) | |
| Sec. 34 Twp. 13 R. 25 <input checked="" type="checkbox"/> East <input type="checkbox"/> West 101' 36" Feet from <input type="checkbox"/> North / <input checked="" type="checkbox"/> South Line of Section 829' 7 1/2" Feet from <input checked="" type="checkbox"/> East / <input type="checkbox"/> West Line of Section JOHNSON _____ County | | Is the pit located in a Sensitive Ground Water Area? <input type="checkbox"/> Yes <input checked="" type="checkbox"/> No Chloride concentration: _____ mg/l <small>(For Emergency Pits and Settling Pits only)</small> | |
| Is the bottom below ground level? <input checked="" type="checkbox"/> Yes <input type="checkbox"/> No | | Artificial Liner? <input checked="" type="checkbox"/> Yes <input checked="" type="checkbox"/> No <i>error</i> | |
| How is the pit lined if a plastic liner is not used? NATIVE CLAY STEEL LINE | | Pit dimensions (all but working pits): 40 _____ Length (feet) 10 _____ Width (feet) <input checked="" type="checkbox"/> N/A: Steel Pits Depth from ground level to deepest point: 4 _____ (feet) <input type="checkbox"/> No Pit | |
| If the pit is lined give a brief description of the liner material, thickness and installation procedure. STEEL TANK | | Describe procedures for periodic maintenance and determining liner integrity, including any special monitoring. WHEN DRILLING IS COMPLETE, TANK WILL BE SUCKED OUT & REMOVED | |
| Distance to nearest water well within one-mile of pit: NONE _____ feet Depth of water well _____ feet | | Depth to shallowest fresh water 100 _____ feet. Source of information: <input type="checkbox"/> measured <input type="checkbox"/> well owner <input type="checkbox"/> electric log <input checked="" type="checkbox"/> KDWR | |
| Emergency, Settling and Burn Pits ONLY: Producing Formation: _____ Number of producing wells on lease: _____ Barrels of fluid produced daily: _____ Does the slope from the tank battery allow all spilled fluids to flow into the pit? <input type="checkbox"/> Yes <input type="checkbox"/> No | | Drilling, Workover and Haul-Off Pits ONLY: Type of material utilized in drilling/workover: WATER/AIR Number of working pits to be utilized: _____ Abandonment procedure: SUCK OUT DRY UP FILL IN Drill pits must be closed within 385 days of spud date. | |
| I hereby certify that the above statements are true and correct to the best of my knowledge and belief. | | | |
| 8/8/11 Date | | Signature of Applicant or Agent | |

15-091-23548-00200

KCC OFFICE USE ONLY

Date Received: 8/16/11 Permit Number: _____ Permit Date: 8/16/11 Lease Inspection: Yes No

Liner Steel Pit RFAC RFAS