

15-167-20542-00-00


STATE OF KANSAS
STATE CORPORATION COMMISSION

Form CP-4

Give All Information Completely
Make Required Affidavit
Mail or Deliver Report to:
Conservation Division
State Corporation Commission
P. O. Box 17027
Wichita, Kansas 67217
NORTH

WELL PLUGGING RECORD

Russell County, Sec. 18 Twp. 14 Rge. 11 (E) W (W)
Location as "NE/CNWxSWx" or footage from lines SE SW NW
Lease Owner Shields Oil Producers, Inc.
Lease Name Stoppel Well No. 1
Office Address Shields Bldg., Russell, Kansas
Character of Well (completed as Oil, Gas or Dry Hole) Dry hole
Date well completed 6-16-19 72
Application for plugging filed 6-16-19 72
Application for plugging approved 6-16-19 72
Plugging commenced 6-16-19 72
Plugging completed 6-16-19 72
Reason for abandonment of well or producing formation Dry hole

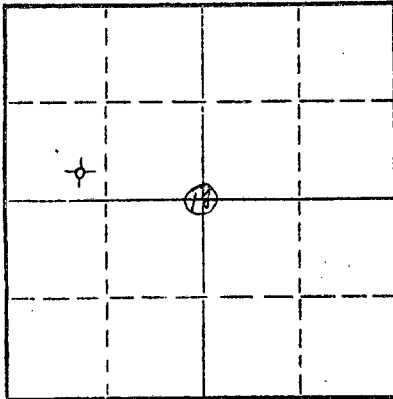

Locate well correctly on above
Section Plat

If a producing well is abandoned, date of last production 19
Was permission obtained from the Conservation Division or its agents before plugging was commenced? Yes

Name of Conservation Agent who supervised plugging of this well Don Truan
Producing formation _____ Depth to top _____ Bottom _____ Total Depth of Well 3,200 Feet
Show depth and thickness of all water, oil and gas formations.

OIL, GAS OR WATER RECORDS

CASING RECORD

FORMATION	CONTENT	FROM	TO	SIZE	PUT IN	PULLED OUT
				8 5/8"	551'	Cmtd. w/290 sax

Describe in detail the manner in which the well was plugged, indicating where the mud fluid was placed and the method or methods used in introducing it into the hole. If cement or other plugs were used, state the character of same and depth placed, from _____ feet to _____ feet for each plug set.

Fill hole w/heavy mud
Push bridge plug to 300'
Spotted 25 sax cement on plug thru 4 1/2" drill pipe
Fill hole w/heavy mud
Push bridge plug to 40' w/1/2 sax hulls on plug
Dump 10 sax cement on plug to cellar

RECEIVED
STATE CORPORATION COMMISSION
JUL 17 1972
CONSERVATION DIVISION
Wichita, Kansas
07-17-72

(If additional description is necessary, use BACK of this sheet)
Name of Plugging Contractor Shields Drilling Co., Inc.
Address Shields Bldg., Russell, Kansas

STATE OF KANSAS, COUNTY OF RUSSELL, ss.
R. L. Shields (employee of owner) or (owner or operator) contractor of the above-described well, being first duly sworn on oath, says: That I have knowledge of the facts, statements, and matters herein contained and the log of the above-described well as filed and that the same are true and correct. So help me God.

(Signature) R. L. Shields, v. pres.
Shields Bldg., Russell, Kansas
(Address)

SUBSCRIBED AND SWORN TO before me this 14th day of July, 1972

My commission expires 26, 1975

Notary Public.





15-167-20542-00-00


Shields

Russell, Kansas

WELL LOG

Operator: Shields Oil Producers, Inc.
 Well: Stoppel #1
 Commenced: June 8, 1972
 Completed: June 16, 1972
 Contractor: Shields Drilling Co., Inc.

Well Description: SE SW NW
 Sec. 18-14S-11W
 Russell Co., Kansas

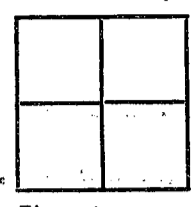

CASING RECORD		
Size	Run	Pulled
8 5/8"	551'	Cmtd. w/290 sax

Elevation:
 Treatment:
 Production: D & A
 Tops:

..... Figures Indicate Bottom of Formations

Topsoil, sand, shale & redbed	420'
Redbed & shale	545'
Anhydrite	577'
Redbed & shale	860'
Shale & salt	1,275'
Shale & lime	2,650'
Lime	3,200' RTD

RECEIVED
 STATE CORPORATION COMMISSION
 JUL 17 1972
 CONSERVATION DIVISION
 Wichita, Kansas

Notes