

STATE OF KANSAS
STATE CORPORATION COMMISSION


Give All Information Completely
Make Required Affidavit
Mail or Deliver Report to:
Conservation Division
State Corporation Commission
800 Bittling Building
Wichita, Kansas

15-167-00403-00-00
WELL PLUGGING RECORD

OR
FORMATION PLUGGING RECORD

Strike out upper line
when reporting plug-
ging off formations.

NORTH

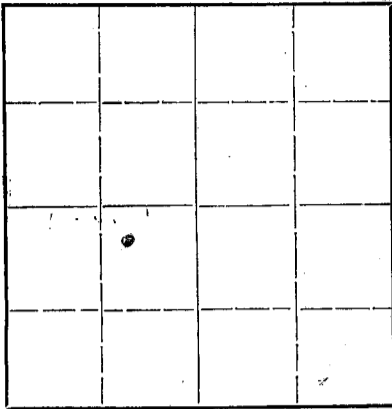

Locate well correctly on above
Section Plat

Russell County. Sec. 17 Twp. 14 Rge. (E) 11 (W)

Location as "NE $\frac{1}{4}$ NW $\frac{1}{4}$ SW $\frac{1}{4}$ " or footage from lines 990' W 330'S From Center
Lease Owner Cities Service Gas Company
Lease Name Stoppel Well No. 1
Office Address Bartlesville, Okla.
Character of Well (completed as Oil, Gas or Dry Hole) Dry Hole
Date, well completed 6/22/41 19.
Application for plugging filed 6/23/41 19.
Application for plugging approved 6/23/41 19.
Plugging Commenced 6/23/41 19.
Plugging Completed 6/23/41 19.
Reason for abandonment of well or producing formation Dry

If a producing well is abandoned, date of last production 19.
Was permission obtained from the Conservation Division or its agents before plugging was com-
menced? Yes

Name of Conservation Agent who supervised plugging of this well C.T. Alexander
Producing formation Arbuckle Lime Depth to top 3188' Bottom Total Depth of Well 3205' Feet
Show depth and thickness of all water, oil and gas formations.


OIL, GAS OR WATER RECORDS

CASING RECORD

Formation	Content	From	To	Size	Put In	Pulled Out
Arbuckle Lime	Dry			7"	248'	0

Describe in detail the manner in which the well was plugged, indicating where the mud fluid was placed and the method or methods used in introducing it into the hole. If cement or other plugs were used, state the character of same and depth placed, from feet to feet for each plug set.

Filled with mud from 3205' to 248', set wood at 248' dumped 25' cement, mud to 33' dumped 25' cement, mud & dirt to surface.

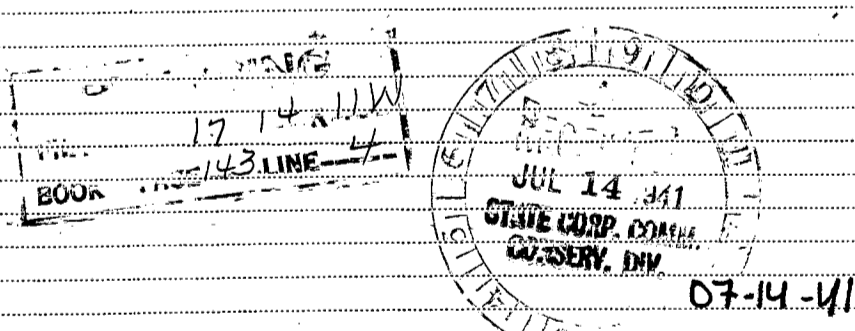

(If additional description is necessary, use BACK of this sheet)

Correspondence regarding this well should be addressed to Mr. R.C. Hauber
Address Cities Service Oil Co. Great Bend, Kansas


STATE OF Kansas, COUNTY OF Russell, ss.
J.A. Cleverley (employee of owner) or (owner or operator) of the above-described well,

being first duly sworn on oath, says: That I have knowledge of the facts, statements, and matters herein contained and the log of the above-described well as filed and that the same are true and correct. So help me God.

(Signature) [Signature]
Cities Service Oil Co. Russell, Kansas (Address)

SUBSCRIBED AND SWORN to before me this 9 day of July, 1941.

My commission expires Jan. 26, 1941

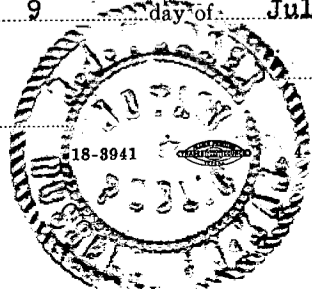

[Signature] Notary Public.

WELL RECORD

Company Cities Service Gas Co. Well No. 1 Farm Stoppel
 Location 390' south & 990' west of Center Sec. 17 T. 14 R. 11-W
 Elevation 1690 County Russell State Kansas
 Drig. Comm. June 5, 1941 Contractor Twin Drilling Company
 Drig. Comp. June 22, 1941 Acid None
 T. D. 3205' Initial Prod. Dry - Plugged and Abandoned

CASING RECORD:

7" O 248' cemented with 75 sacks cement.


FORMATION RECORD:

surface	0-157
sandy shale	248
shale & shells	290
sand	330
shale	340
shale & shells	527
anhydrite	555
shale & shells	675
sand iron shells	715
shale & shells	1060
sandy shale	1070
shale & shells	1314
gypsum	1365
shale & shells	1372
lime grey med.	1440
lime broken	1580
lime brown hard	1595
lime light hard	1695
lime grey medium	1737
lime light med. & shale breaks	1821
red shale & shells	1831
lime light hard	1945
shale & shells	2178
lime hard	2182
shale & shells	2185
lime	2190
lime light hard	2193
broken lime	2226
shale & shells	2471
lime grey hard	2496
shale & shells	2550
lime grey med.	2560
shale & shells	2597
lime light hard	2625
lime	2629
shale & shells	2645
lime	2672
broken lime	2788
lime hard	2805
lime grey hard	2826

lime grey soft	2843
lime grey	2888
lime	2892
lime hard	2902
lime med. soft	2925
lime soft	2929
lime light hard	3029
lime & shale breaks	3039
lime light hard	3118
shale grey	3131
chert	3132
shale grey	3139
lime & shale breaks	3153
conglomerate	3159
shale & shells	3188
Arbuckle lime	3205 T. D.

Top Lensing	2787
Top Arbuckle	3188
Penetration	17'
Total Depth	3205

Syfo: 500' 0°
 1000' 0°
 1500' 0°
 2500' 0°

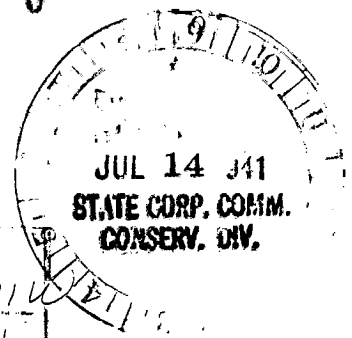

17 14 1100 4