


STATE OF KANSAS
STATE CORPORATION COMMISSION

Give All Information Completely
Make Required Affidavit
Mail or Deliver Report to:
Conservation Division
State Corporation Commission
P. O. Box 17027
Wichita, Kansas 67217

WELL PLUGGING RECORD

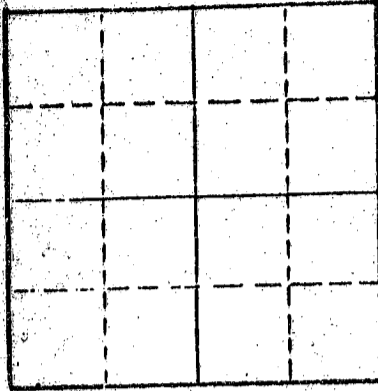

Locate well correctly on above
Section Plat

Russell County, Sec. 14 Twp. 14 Rge. 11 (E) (W)
Location as "NE/CNW/SE" or footage from lines. SW SE SE
Lease Owner Fender Pipe & Supply
Lease Name Amchutz #1 Well No.
Office Address Russell, Kansas 67665
Character of Well (completed as Oil, Gas or Dry Hole)
Date well completed 10
Application for plugging filed 10
Application for plugging approved 10
Plugging commenced 12/12/74 10
Plugging completed 12/18/74 10
Reason for abandonment of well or producing formation depleted.
If a producing well is abandoned, date of last production 10
Was permission obtained from the Conservation Division or its agents before plugging was commenced? yes

Name of Conservation Agent who supervised plugging of this well Truan
Producing formation Depth to top Bottom Total Depth of Well 2200 Feet
Show depth and thickness of all water, oil and gas formations.

OIL, GAS OR WATER RECORDS

CASING RECORD

FORMATION	CONTENT	FROM	TO	SIZE	PUT IN	PULLED OUT
				8-5/8 5-7/8	261 2199	none 1666'

Describe in detail the manner in which the well was plugged, indicating where the mud fluid was placed and the method or methods used in introducing it into the hole. If cement or other plugs were used, state the character of same and depth placed, from feet to feet for each plug set.

Checked bottom, ran sand to 2100' and dumped 5 sacks cement. Shot pipe at 1900', 1835', 1805', 1735', 1703', 1636', pulled 52 joints. Pumped 4 sacks hulls, 25 sacks gel and 100 sacks cement.

PLUGGING COMPLETE.

RECEIVED
STATE CORPORATION COMMISSION
JAN 10 1975
CONSERVATION DIVISION
Wichita, Kansas

(If additional description is necessary, use BACK of this sheet)
Name of Plugging Contractor KNIGHT CASING PULLING CO., INC.
Address CHASE, KANSAS

STATE OF KANSAS COUNTY OF RICE ss.
NOEL J. KNIGHT (employee of owner) or (owner or operator) of the above-described well, being first duly sworn on oath, says: That I have knowledge of the facts, statements, and matters herein contained and the log of the above-described well as filed and that the same are true and correct. So help me God.

(Signature) Noel Knight
CHASE, KANSAS
(Address)

SUBSCRIBED AND SWORN TO before me this 19th day of December, 1974

Margaret Melcher
Notary Public

My commission expires

