


Give All Information Completely
Make Required Affidavit
Mail or Deliver Report to:
Conservation Division
State Corporation Commission
212 No. Market
Wichita, Kansas

WELL PLUGGING RECORD

NORTH

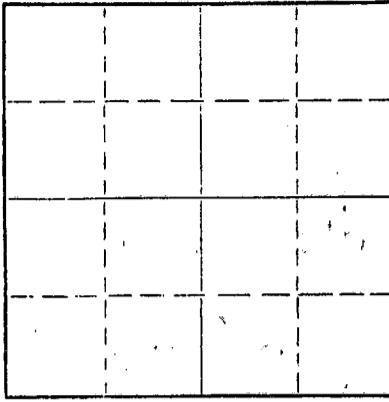

Locate well correctly on above Section Plat

Russell County, Sec. 11 Twp. 14 Rge. 11 (E) W (W)
Location as "NE/CNW%SW%" or footage from lines SE SE SE
Lease Owner Dreiling & Borell
Lease Name Eschbaugh "B" Well No. 1
Office Address Route 2, Victoria, Kansas 67671
Character of Well (completed as Oil, Gas or Dry Hole) Dry Hole
Date well completed 2-10 1970
Application for plugging filed 2-10 1970
Application for plugging approved 2-10 1970
Plugging commenced 2-10 1970
Plugging completed 2-10 1970
Reason for abandonment of well or producing formation Dry Hole

If a producing well is abandoned, date of last production 19
Was permission obtained from the Conservation Division or its agents before plugging was commenced? Yes

Name of Conservation Agent who supervised plugging of this well Don Truan
Producing formation _____ Depth to top _____ Bottom _____ Total Depth of Well _____ Feet
Show depth and thickness of all water, oil and gas formations.

OIL, GAS OR WATER RECORDS

CASING RECORD

FORMATION	CONTENT	FROM	TO	SIZE	PUT IN	PULLED OUT
Surface Pipe				8 5/8"	305'	

Describe in detail the manner in which the well was plugged, indicating where the mud fluid was placed and the method or methods used in introducing it into the hole. If cement or other plugs were used, state the character of same and depth placed, from _____ feet to _____ feet for each plug set.

1st. plug was set @ 450' with 40 sacks cement
2nd. plug was set @ 300' with 25 sacks cement
3rd. plug was set @ 40' with 10 sacks cement
Cementing to bottom of cellar

RECEIVED
STATE CORPORATION COMMISSION
FEB 13 1970
CONSERVATION DIVISION
Wichita, Kansas


(If additional description is necessary, use BACK of this sheet)

Name of Plugging Contractor L. J. Dreiling & Sons, Inc.
Address Route 2, Victoria, Kansas 67671

STATE OF KANSAS, COUNTY OF ELLIS, ss.
I, Leo F. Dreiling (employee of owner) or (owner or operator) of the above-described well, being first duly sworn on oath, says: That I have knowledge of the facts, statements, and matters herein contained and the log of the above-described well as filed and that the same are true and correct. So help me God.

(Signature) Leo F. Dreiling
LEO F. DREILING, ROUTE 2, VICTORIA, KANSAS 67671
(Address)

Subscribed and Sworn to before me this 12th day of February, 19 70

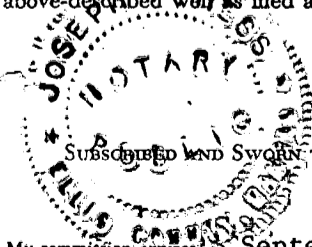

My commission expires September 19, 1970 JOSEPH A. HESS Notary Public.

L. J. DREILING AND SONS, INC.

Victoria, Kansas 67671

15-167-20394-00-00

WELL LOG

Company	Dreiling & Borell Route 2 Victoria, Kansas 67671	Sec. 11	Twp. 14	Rng. 11
Farm	Eschbaugh "B" No. 1	Location	SE SE SE	
Total Depth	2973'	County	Russell	
Comm.	2-5-70	Comp.	2-10-70	Elevation: 1762' K. B.
Contractor	L. J. Dreiling & Sons, Inc. Victoria, Kansas 67671			1759' D. F.
		Casing Record	Cement Record	1757' G. R.
		305' - 8 5/8"	150 sacks cement	Production: D & A

Figures Indicate Bottom of Formations

0'	40'	Surface Soil & Post Rock
40'	305'	Shale
305'	572'	Redbed
572'	600'	Anhy.
600'	1260'	Shale
1260'	2540'	Shale & Lime
2540'	2785'	Lime
2785'	2885'	Shale & Lime
2885'	2973'	Lime
2973'	T.D.	

RECEIVED
 STATE CORPORATION COMMISSION
 FEB 13 1970
 CONSERVATION DIVISION
 Wichita, Kansas

STATE OF KANSAS)
)ss
 COUNTY OF ELLIS)

I, Leo F. Dreiling, of the L. J. Dreiling & Sons, Inc., upon oath states that the above and foregoing is a true and correct copy from the Daily Drilling Report from your Eschbaugh "B" #1.

Leo F. Dreiling

 LEO F. DREILING

Subscribed and sworn to before me this 12th day of February 1970.

Joseph A. Hess

 JOSEPH A. HESS NOTARY PUBLIC

JOSEPH A. HESS
 NOTARY PUBLIC
 *
 COUNTY OF ELLIS

My commission expires: September 19, 1970