

STATE OF KANSAS
STATE CORPORATION COMMISSION

WELL PLUGGING RECORD


Give All Information Completely
Make Required Affidavit
Mail or Deliver Report to:
Conservation Division
State Corporation Commission
800 Biting Building
Wichita, Kansas

OR

FORMATION PLUGGING RECORD

Strike out upper line
when reporting plug-
ging off formations.

NORTH

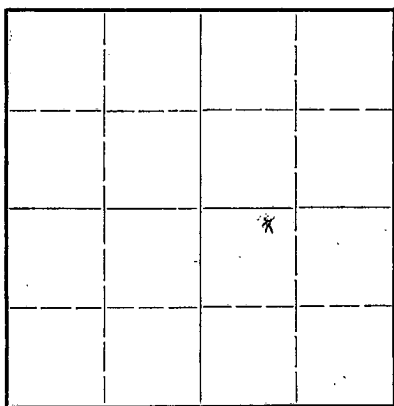

Locate well correctly on above
Section Plat

ELLIS County. Sec. 3 Twp. 14 Rge. 16 (E) (W)

Location as "NE 1/4 NW 1/4 SW 1/4" or footage from lines 660 N OF S LINE, 330 W OF E

Lease Owner HERNDON DRILLING COMPANY

Lease Name HERMAN

Well No. 11

Office Address Box 1826 TULSA, OKLAHOMA

Character of Well (completed as Oil, Gas or Dry Hole) DRY HOLE

Date well completed 9-4-46 19

Application for plugging filed 9-4-46 19

Application for plugging approved 9-4-46 19

Plugging commenced 9-5-46 19

Plugging completed 9-5-46 19

Reason for abandonment of well or producing formation

DRY

If a producing well is abandoned, date of last production 19

Was permission obtained from the Conservation Division or its agents before plugging was commenced? YES

Name of Conservation Agent who supervised plugging of this well MR. KERR - GREAT BEND, KANSAS

Producing formation Depth to top Bottom Total Depth of Well 3,510 Feet

Show depth and thickness of all water, oil and gas formations.

OIL, GAS OR WATER RECORDS


CASING RECORD

Formation	Content	From	To	Size	Put In	Pulled Out
				8-5/8	1,055	NONE

Describe in detail the manner in which the well was plugged, indicating where the mud fluid was placed and the method or methods used in introducing it into the hole. If cement or other plugs were used, state the character of same and depth placed, from _____ feet to _____ feet for each plug set:

FILLED HOLE WITH 11 LB MUD TO 350 FEET; BRIDGED HOLE AT 350 FEET; PUT 15 SACKS OF CEMENT ON BRIDGE. FILLED HOLE WITH MUD TO 10 FEET BELOW CELLAR BOTTOM; BRIDGED HOLE AND FILLED WITH CEMENT TO BOTTOM OF CELLAR.

PLUGGING
FILE SEC 3 14 16 W
BOOK PAGE 71 LINE 30

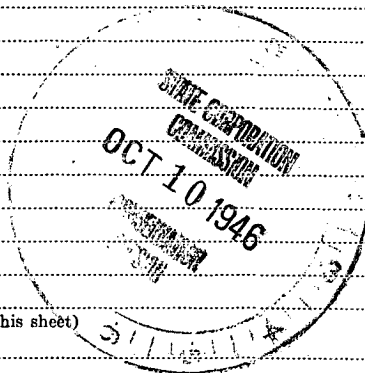

110-10-46

(If additional description is necessary, use BACK of this sheet)

Correspondence regarding this well should be addressed to

Address

STATE OF Oklahoma COUNTY OF Tulsa ss.

I, W. G. PRATHER, (employee of owner) or (owner) of the above-described well, being first duly sworn on oath, says: That I have knowledge of the facts, statements, and matters herein contained and the log of the above-described well as filed and that the same are true and correct. So help me God.

(Signature)

W. G. Prather

(Address)

SUBSCRIBED AND SWORN to before me this 19th day of September 19 46

Louise Toomey
Notary Public.

July 30, 1950

