

15-051-01441-00-00




STATE OF KANSAS
STATE CORPORATION COMMISSION

WELL PLUGGING RECORD

Give All Information Completely
Make Required Affidavit
Mail or Deliver Report to
Conservation Division
State Corporation Comm.
245 North Water
Wichita, KS 67202

Ellis County. Sec. 6 Twp. 14 Rge. 17 NE/SW
Location as "NE/CNW/SW" or footage from lines NE SE NE
Lease Owner Mid States Sales & Serv.
Lease Name Younger Well No. 1
Office Address Box 1366, Great Bend, Ks.
Character of Well (Completed as Oil, Gas or Dry Hole) Dry Hole

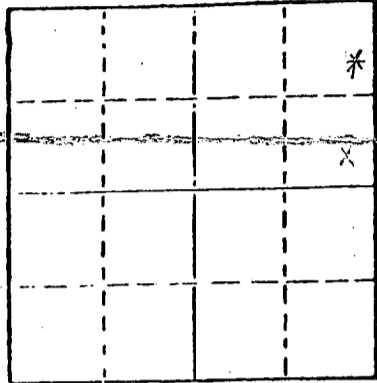

Locate well correctly on above
Section Plat

Date Well completed 12-13 1976
Application for plugging filed 12-15 1976
Application for plugging approved Dec. 28 1976
Plugging commenced Dec. 29 1976
Plugging completed Dec. 29 1976
Reason for abandonment of well or producing formation _____

If a producing well is abandoned, date of last production _____ 19____

Was permission obtained from the Conservation Division or its agents before plugging was commenced? Yes

Name of Conservation Agent who supervised plugging of this well Leo Massey
Producing formation _____ Depth to top _____ Bottom _____ Total Depth of Well 3583
Show depth and thickness of all water, oil and gas formations.

OIL, GAS OR WATER RECORDS

CASING RECORD

| FORMATION | CONTENT | FROM | TO | SIZE | PUT IN | PULLED OUT |
|-----------|---------|------|----|------|--------|------------|
| | | | | | | |
| | | | | | | |
| | | | | | | |
| | | | | | | |
| | | | | | | |

Describe in detail the manner in which the well was plugged, indicating where the mud fluid was placed and the method or methods used in introducing it into the hold. If cement or other plugs were used, state the character of same and depth placed, from _____ feet to _____ feet for each plug set.

3376 pounds gel.
400 pounds cottonseed hulls
100 sacks cement
1-5 1/2" (Tape Hole, Wood)

RECEIVED
STATE CORPORATION COMMISSION

MAR 03 1977

CONSERVATION DIVISION
Wichita, Kansas

(If additional description is necessary, use BACK of this sheet)

Name of Plugging Contractor Sun Oil Well Cementing

STATE OF KANSAS COUNTY OF BARTON, ss.
CLETUS YOUNGER (employee of owner) or (owner or operator)

of the above-described well, being first duly sworn on oath, says: That I have knowledge of the facts, statements, and matters herein contained and the log of the above-described well as filed and that the same are true and correct. So help me God.

(Signature) Cletus Younger
1416 TAFT, GREAT BEND, KANSAS 67530
(Address)

SUBSCRIBED AND SWORN TO before me this 24TH day of FEBRUARY, 1977

Glen W. Nuss
Notary Public.

