

15-051-00288-00-00

STATE OF KANSAS  
STATE CORPORATION COMMISSION


WELL PLUGGING RECORD

Give All Information Completely  
Make Required Affidavit  
Mail or Deliver Report to:  
Conservation Division  
State Corporation Commission  
800 Bittling Building  
Wichita, Kansas

Ellis County, Sec. 6 Twp. 14 Rge. (E) 17 (W)

Location as "NE/CNW/SW" or footage from lines c. NE/4 SW/4 SE/4  
Lease Owner Musgrove Petroleum Corporation  
Lease Name Younger Well No. 1  
Office Address Wichita, Kansas  
Character of Well (completed as Oil, Gas or Dry Hole) Dry Hole  
Date well completed April 14 19. 53  
Application for plugging filed April 14 19. 53  
Application for plugging approved April 14 19. 53  
Plugging commenced April 14 19. 53  
Plugging completed April 14 19. 53  
Reason for abandonment of well or producing formation Dry Hole

NORTH

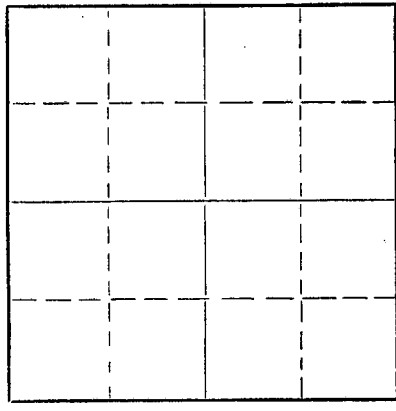

Locate well correctly on above Section Plat

If a producing well is abandoned, date of last production \_\_\_\_\_ 19\_\_\_\_  
Was permission obtained from the Conservation Division or its agents before plugging was commenced? Yes

Name of Conservation Agent who supervised plugging of this well Eldon R. Petty  
Producing formation \_\_\_\_\_ Depth to top \_\_\_\_\_ Bottom \_\_\_\_\_ Total Depth of Well 3548 Feet  
Show depth and thickness of all water, oil and gas formations.

OIL, GAS OR WATER RECORDS

CASING RECORD

FORMATION	CONTENT	FROM	TO	SIZE	PUT IN	PULLED OUT
				8 5/8	151.21	None
				(Cemented top to bottom)		

Describe in detail the manner in which the well was plugged, indicating where the mud fluid was placed and the method or methods used in introducing it into the hole. If cement or other plugs were used, state the character of same and depth placed, from 3548 feet to 0 feet for each plug set.

Filled hole with heavy rotary mud to 155'  
Set a bridging plug at 155'  
Placed 1/2 sack of hulls on top of plug.  
Placed 20 sacks cement on top of hulls.  
Filled hole with rotary mud to 35'.  
Set a bridging plug at 35'.  
Placed 1/2 sack of hulls on top of plug.  
Placed 10 sacks of cement on top of hulls to top of ground.

RECEIVED  
STATE CORPORATION COMMISSION  
APR 13 1953  
04-18-53  
CONSERVATION DIVISION  
Wichita, Kansas

(If additional description is necessary, use BACK of this sheet)  
Name of Plugging Contractor Stearns Drilling Company  
Address Russell, Kansas

STATE OF KANSAS, COUNTY OF RUSSELL, ss.  
O. G. Stearns (employee of owner) or (owner or operator) of the above-described well, being first duly sworn on oath, says: That I have knowledge of the facts, statements, and matters herein contained and the log of the above-described well as filed and that the same are true and correct. So help me God.

(Signature) [Signature]  
Russell, Kansas  
(Address)

SUBSCRIBED AND SWORN TO before me this 17th day of April, 1953  
June 20, 1953  
[Signature] Notary Public.



PLUGGING  
FILE SEC-6-T-14-R-19W  
BOOK PAGE-93 LINE-40

YOUNGER #1

Operator: Musgrove Petroleum Corporation  
 Contractor: Stearns Drilling Company  
 Commencement Date: April 4, 1953  
 Completion Date: April 14, 1953

Location: c. NE/4 SW/4 SE/4  
 Section 6-14-17  
 Ellis Co., Kansas

Casing Record:

8 5/8" 151.21' Cemented with 100 sacks.

WELL LOG

Shale and Clay	0	40
Shale	40	80
Shale and Sand	80	130
Shale	130	159
Shale and Shells	159	264
Shale and Red Bed	264	660
Sand and Shale	660	850
Shale and Red Bed	850	1195
Anhydrite	1195	1230
Shale and Shells	1230	2000
Shale and Lime	2000	3065
Lime	3065	3175
Lime and Shale	3175	3225
Lime	3225	3239
Heebner Shale	3239	3242
Lime	3242	3522
Conglomerate	3522	3548
Total Depth:	3548	

STATE OF KANSAS )  
 ) SS:  
 COUNTY OF RUSSELL )

I hereby certify that the above information is true and correct to the best of my knowledge.

*[Signature]*

SUBSCRIBED AND SWORN to before me this 17th day of April, 1953.



*[Signature]*  
 Notary Public

My Commission Expires: June 20, 1953.

RECEIVED  
 STATE CORPORATION COMMISSION  
 APR 18 1953  
 CONSERVATION DIVISION  
 Wichita, Kansas

**PLUGGING**  
 FILE CSC-6-T-14-R-17N  
 BOOK PAGE 93 LINK 40