

STATE OF KANSAS CORPORATION COMMISSION

WELL PLUGGING RECORD

Give All Information Completely Make Required Affidavit Mail or Deliver Report to Conservation Division State Corporation Comm. 245 North Water Wichita, KS 67202

Ellis County, Sec. 6 Twp. 14 Rge. 17 NW

Location as "NE/CNW/SW" or footage from lines

330'/N1, 2310'/W1, SW4

Lease Owner Dreiling Ltd. of Colorado

Lease Name Hoffman Well No. #1

Office Address 410 - 17th St., Suite 1140, Denver, Colo. 80202

Character of Well (Completed as Oil, Gas or Dry Hole)

Dry Hole

Date Well completed October 2 19 82

Application for plugging filed October 7 19 82

Application for plugging approved October 2 19 82

Plugging commenced 6:45 A.M. October 2 19 82

Plugging completed 8:45 A.M. October 2 19 82

Reason for abandonment of well or producing formation


Non-productive

If a producing well is abandoned, date of last production

None

19

Was permission obtained from the Conservation Division or its agents before plugging was commenced? Yes

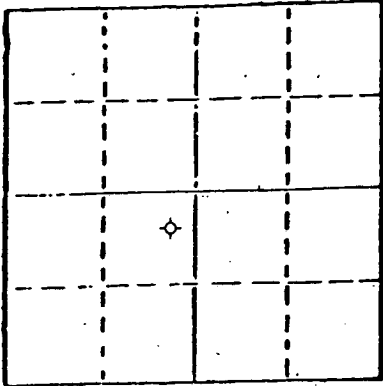

Locate well correctly on above Section Plot

Name of Conservation Agent who supervised plugging of this well Carl Goodrow

Producing formation Depth to top Bottom Total Depth of Well 3650

Show depth and thickness of all water, oil and gas formations.

OIL, GAS OR WATER RECORDS

CASING RECORD

Table with 7 columns: FORMATION, CONTENT, FROM, TO, SIZE, PUT IN, PULLED OUT. Rows include Lansing (150' muddy wt) and Base of Lansing (30' muddy wtr).

Describe in detail the manner in which the well was plugged, indicating where the mud fluid was placed and the method or methods used in introducing it into the hole. If cement or other plugs were used, state the character of same and depth placed, from feet to feet for each plug set.

Hole full of heavy mud=cemented plugs through drill pipe with 150 sacks 50/50 pozmix with 4% gel, 3% cc as follows: 1st cement plug at 660' with 80 sacks 2nd cement plug at 230' with 40 sacks 3rd wood and rubber 8-5/8 plug at 40' with 10 sacks 10 sacks rathole 10 sacks mousehole

(If additional description is necessary, use BACK of this sheet)

Name of Plugging Contractor Halliburton

STATE OF COLORADO COUNTY OF DENVER, ss. Leslie Olson (employee of owner) or (owner or operator) of the above-described well, being first duly sworn on oath, says: That I have knowledge of the facts, statements, and matters herein contained and the log of the above-described well as filed and that the same are true and correct. So help me God.

(Signature)

Handwritten signature of Leslie Olson

(Address)

SUBSCRIBED AND SWORN TO before me this 7th day of October, 19 82

Signature of Notary Public Lorraine C. Murphy

My commission expires 9-2-83

RECEIVED STATE CORPORATION COMMISSION OCT 12 1982 CONSERVATION DIVISION Wichita, Kansas