


STATE OF KANSAS
STATE CORPORATION COMMISSION

WELL PLUGGING RECORD

Give All Information Completely
Make Required Affidavit
Mail or Deliver Report to
Conservation Division
State Corporation Comm.
245 North Water
Wichita, KS 67202

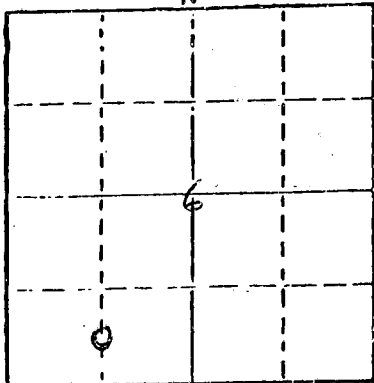

Ellis County. Sec. 6 Twp. 14S Rge. 17 E/W
Location as "NE/CNW $\frac{1}{4}$ SW $\frac{1}{4}$ " or footage from lines
C S/2 SW/4
Lease Owner TGT Petroleum, Inc.
Lease Name Hoffman Well No. 1
Office Address 209 E. William, Suite 615, Wichita, Ks. 67202
Character of Well (Completed as Oil, Gas or Dry Hole)
Dry Hole
Date Well completed July 10, 1978
Application for plugging filed (verbally) July 10, 1978
Application for plugging approved (verbally) July 10, 1978
Plugging commenced July 10, 1978
Plugging completed July 10, 1978
Reason for abandonment of well or producing formation
No commercial quantity of oil or gas encountered
If a producing well is abandoned, date of last production 19

Name of Conservation Agent who supervised plugging of this well Leo Massey
Producing formation Depth to top Bottom Total Depth of Well 3625'
Show depth and thickness of all water, oil and gas formations.

OIL, GAS OR WATER RECORDS

CASING RECORD

FORMATION	CONTENT	FROM	TO	SIZE	PUT IN	PULLED OUT

Describe in detail the manner in which the well was plugged, indicating where the mud fluid was placed and the method or methods used in introducing it into the hold. If cement or other plugs were used, state the character of same and depth placed, from feet to feet for each plug set.

Set 1st plug at 500' with 50 sacks
2nd plug at 185' with 25 sacks
40' solid bridge with 10 sacks
Cemented with 50-50 posmix, 2% gel.


(If additional description is necessary, use BACK of this sheet)

Name of Plugging Contractor Abercrombie Drilling, Inc.

STATE OF KANSAS COUNTY OF SEDGWICK, ss.
Jack L. Partridge, Ass't. Secretary-Treasurer (employee of owner) or (owner or operator)
of the above-described well, being first duly sworn on oath, says: That I have knowledge of
the facts, statements, and matters herein contained and the log of the above-described well
as filed and that the same are true and correct. So help me God.

(Signature) Jack L. Partridge
801 Union Center, Wichita, Kansas 67202
(Address)

SUBSCRIBED AND SWORN TO before me this 12th day of July, 1978.

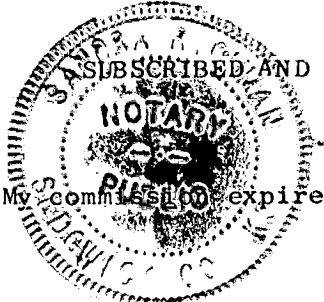

Sandra Richman
Sandra Richman
STATE CORPORATION COMMISSION
Notary Public.

JUL 13 1978
CONSERVATION DIVISION
Wichita, Kansas

OPERATOR: TGT Petroleum, Inc.
CONTRACTOR: Abercrombie Drilling, Inc.
WELL NAME: Hoffman #1
LOCATION: C S/2 SW/4 Section 6-14S-17W
Ellis County, Kansas
SPUD DATE: July 2, 1978
COMPLETION DATE: July 10, 1978

0	210	Surface clay, sand & shale
210	1233	Shale & sand
1233	1270	Anhydrite
1270	1445	Shale & sand
1445	1940	Sand & shale
1940	2270	Shale
2270	3120	Shale & lime
3120	3330	Lime & shale
3330	3405	Lime
3405	3465	Lime & shale
3465	3565	Lime
3565	3585	Lime & shale
3585	3625	Lime
	3625	Rotary Total Depth

Spud hole at 6:00 p.m., July 2, 1978. Drilled 210' of 12 $\frac{1}{4}$ " hole. Ran 5 joints of 8-5/8" surface casing. Set at 209' K.B. with 165 sacks common cement, 3% CaCl, 2% gel. Cement did circulate. Plug was down at 10:45 p.m., July 2, 1978.

T.D. 3625'. Set first plug at 500' with 50 sacks, second plug at 185' with 25 sacks, 40' solid bridge with 10 sacks. Cemented with 50/50 posmix, 2% gel. Plug was down at 10:00 a.m., July 10, 1978. State Plugger - Leo Massey.

SAMPLE TOPS:

Anhydrite	1233'
B/Anhydrite	1270'

STATE OF KANSAS)
COUNTY OF SEDGWICK) ss

Jack L. Partridge, Assistant Secretary-Treasurer of Abercrombie Drilling, Inc., does hereby state that the above and foregoing is a true and correct copy of the log of the Hoffman #1, C S/2 SW/4 Section 6-14S-17W, Ellis County, Kansas.

ABERCROMBIE DRILLING, INC.

BY Jack L. Partridge
Jack L. Partridge,
Assistant Secretary-Treasurer

Subscribed and sworn to before me, a Notary Public, in and for the County of _____ state aforesaid, as of this 12th day of July, 1978.

Sandra Richman 13 1978
Sandra Richman, Notary Public
CONSERVATION DIVISION
Wichita, Kansas

My commission expires July 21, 1979

NOTARY
PUBLIC