


STATE OF KANSAS
STATE CORPORATION COMMISSION

15-051-00758-00-00
WELL PLUGGING RECORD

Give All Information Completely
Make Required Affidavit
Mail or Deliver Report to:
Conservation Division
State Corporation Commission
211 No. Broadway
Wichita, Kansas

Ellis County, Sec. 6 Twp. 14 Rge. 17 (W)
Location as "NE/CNW/SW" or footage from lines NE 1/4 NE 1/4 NE 1/4
Lease Owner Leben Drilling, Inc. & Glenn Nye
Lease Name Younger Well No. 1
Office Address 905 Central Bldg., Wichita, Kansas
Character of Well (completed as Oil, Gas or Dry Hole) Dry Hole
Date well completed 12-5-58 19
Application for plugging filed 12-5-58 19
Application for plugging approved 12-5-58 19
Plugging commenced 12-5-58 19
Plugging completed 12-5-58 19
Reason for abandonment of well or producing formation Dry Hole

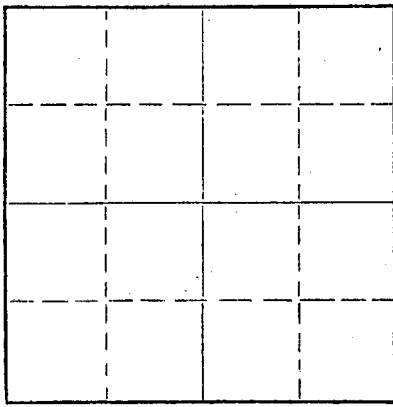

Locate well correctly on above Section Plat

If a producing well is abandoned, date of last production - 19
Was permission obtained from the Conservation Division or its agents before plugging was commenced? yes

Name of Conservation Agent who supervised plugging of this well Eldon Petty
Producing formation _____ Depth to top _____ Bottom _____ Total Depth of Well 3618' Feet
Show depth and thickness of all water, oil and gas formations.

OIL, GAS OR WATER RECORDS

CASING RECORD

FORMATION	CONTENT	FROM	TO	SIZE	PUT IN	PULLED OUT
				8 5/8"	212'	

Describe in detail the manner in which the well was plugged, indicating where the mud fluid was placed and the method or methods used in introducing it into the hole. If cement or other plugs were used, state the character of same and depth placed, from _____ feet to _____ feet for each plug set.
1st plug @ 500' w/20 sacks cement
2nd plug @ 180' w/20 sacks cement
Top plug @ 40' w/10 sacks cement

(If additional description is necessary, use BACK of this sheet)
Name of Plugging Contractor Leben Drilling, Inc.
Address 905 Central Bldg., Wichita, Kansas

STATE OF Kansas, COUNTY OF Sedgwick, ss.
I, Frank Hamlin (employee of owner) or (owner or operator) of the above-described well, being first duly sworn on oath, says: That I have knowledge of the facts, statements, and matters herein contained and the log of the above-described well as filed and that the same are true and correct. So help me God.
(Signature) Frank Hamlin
905 Central Bldg., Wichita, Kansas (Address)

SUBSCRIBED AND SWORN TO before me this 12th day of December, 19 58
My commission expires June 17, 1961
Ruth N. Benjamin Notary Public.
STATE CORPORATION COMMISSION



PLUGGING
FILE SEC. 6 T. 14 R. 17 W
BOOK PAGE 4 LINE 5

DEC 20 1958
CONSERVATION DIVISION
Wichita, Kansas

DRILLER'S LOG

COMPANY:
CONTRACTOR:
FAH:
LOCATION:

COMMENCED:
COMPLETED:

LEBEN DRILLING, INC.
LEBEN DRILLING, INC.
YOUNGER #1
NE $\frac{1}{4}$ NE $\frac{1}{4}$ NE $\frac{1}{4}$ SEC. 6-14S-17W
ELLIS COUNTY, KANSAS
11-26-58
12-5-58

0	40	Clay & Sand	
40	213	Shale	
213	880	Shale & Sand	
880	1085	Shale, Shells, & Red Bed	
1085	1220	Red Bed	
1220	1262	Anhydrite	TOPS:
1262	1425	Shale & Shells	Anhydrite 1220' +790
1425	1885	Shale	Heebner 3263' -1253
1885	2505	Lime & Shale	Lansing 3308' -1298
2505	3265	Shale & Lime	Arbuckle 3609' -1599
3265	3268	Heebner	
3268	3310	Lime & Shale	ELEVATION 2010' K. B.
3310	3385	K. G. Lime	
3385	3450	Lime	
3450	3495	Lime & Shale	
3495	3550	Lime	
3550	3610	Conglomerate	
3610	3618	Arbuckle	
	3618	Notary Total Depth - D. & A.	

Fidelity Onion Skin

Set 212' of 8 5/8" surface casing with 140 sacks cement and 25 C&G.

I, Frank Healin, do hereby certify that the above and foregoing is a true and correct copy of the log of the Younger #1, located NE $\frac{1}{4}$ NE $\frac{1}{4}$ NE $\frac{1}{4}$ of Section 6- Township 14 South, Range 17 West, Ellis County, Kansas, as reflected by the files of Leben Drilling, Inc.

LEBEN DRILLING, INC.

By: Frank Healin
Frank Healin

STATE OF KANSAS)
) SS
COUNTY OF SEDGWICK)

Subscribed and sworn to before me, a Notary Public, in and for Sedgwick County, Kansas, this 16th day of December, 1958.

Ruth M. Benjamin
Ruth M. Benjamin, Notary Public

My Commission Expires:
June 17, 1961.

RECEIVED
STATE CORPORATION COMMISSION

DEC 20 1958

CON. DIVISION

PLUGGING
FILE SEC 6 T 14 R 17W
BOOK PAGE 4 LINE 5