


Give All Information Completely
Make Required Affidavit
Mail or Deliver Report to:
Conservation Division
State Corporation Commission
211 No. Broadway
Wichita, Kansas

WELL PLUGGING RECORD

Ellis County, Sec. 7 Twp. 14 Rge. 17 (E) (W)

NORTH

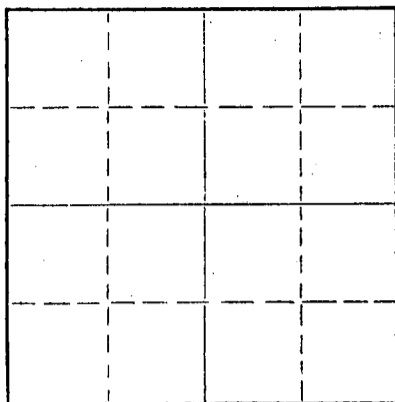

Locate well correctly on above
Section Plat

Location as "NE/CNWxSWx" or footage from lines NW NW SW
Lease Owner Woodman & Iannitti-Aurora-Bailey
Lease Name Stecklein Well No. 1
Office Address P. O. Box 387, Hoisington, Kansas
Character of Well (completed as Oil, Gas or Dry Hole) Dry Hole
Date well completed 12-13 1957
Application for plugging filed 12-13 1957
Application for plugging approved 12-13 1957
Plugging commenced 12-13 1957
Plugging completed 12-13 1957
Reason for abandonment of well or producing formation Dry.

If a producing well is abandoned, date of last production 19
Was permission obtained from the Conservation Division or its agents before plugging was commenced? Yes

Name of Conservation Agent who supervised plugging of this well Eldon Petty
Producing formation _____ Depth to top _____ Bottom _____ Total Depth of Well 3606 Feet
Show depth and thickness of all water, oil and gas formations.

OIL, GAS OR WATER RECORDS

CASING RECORD

FORMATION	CONTENT	FROM	TO	SIZE	PUT IN	PULLED OUT
				8 5/8"	199	

Describe in detail the manner in which the well was plugged, indicating where the mud fluid was placed and the method or methods used in introducing it into the hole. If cement or other plugs were used, state the character of same and depth placed, from _____ feet to _____ feet for each plug set.

Filled pits with heavy rotary mud. Bottom plug 500' - 20 sacks, Middle plug 180' - 20 sacks, top plug 40' - 1/3 sack of hulls and 10 sacks cement.

(If additional description is necessary, use BACK of this sheet)

Name of Plugging Contractor Sun Oil Well Cementing, Inc.
Address Box 89, Hays, Kansas

STATE OF KANSAS, COUNTY OF SEDGWICK, ss.
K. T. Woodman (owner or operator) of the above-described well, being first duly sworn on oath, says: That I have knowledge of the facts, statements, and matters herein contained and the log of the above-described well as filed and that the same are true and correct. So help me God.

(Signature) K. T. Woodman

717 Union Nat'l. Bldg., Wichita 2, Kansas
(Address)

SUBSCRIBED AND SWORN to before me this 13th day of December, 1957




STATE CORP. COMMISSION

12-17-57
DEC 17 1957

CONSERVATION DIVISION

Mildred E. Lick
Mildred E. Lick, Notary Public.

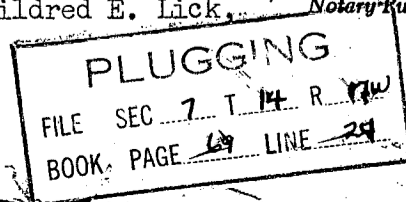

DRILLING LOG

Company: Woodman & Iannitti-Aurora-Bailey
 Lease: #1 STECKLEIN NW NW SW 7-14-17W
 Ellis County, Kansas
 Contractor: Woodman & Iannitti Drilling Company
 P. O. Box 387, Hoisington, Kansas
 Date Commenced: December 3, 1957
 Date Completed: December 13, 1957
 Total Depth: 3606'
 Casing: 8 5/8" set at 199 with 125 sacks cement

Figures Indicate the Bottom
of Formation

0 - 60	Sand Clay	2513	Lime
170	Post Rock	3050	Lime - Shale
195	Blue Shale	3204	Lime
310	Shale	3250	Lime - Shale
360	Sand	3606	Lime
680	Shale		
900	Sand		
975	Redbed		
1238	Sand & Redbed		
1280	Anhydrite		
1300	Shale & Shells		
1940	Shale & Shells		
1990	Shale - Lime		
2280	Shale - Lime		

GEOLOGICAL TOPS

Anhydrite	1241	759
Heebner	3303	-1303
Toronto	3319	-1319
Lansing	3346	-1346
B/KC	3574	-1574
Conglomerate	3584	-1584
Arbuckle	3588	-1588
Total Depth	3606	-1606

I certify the above to be true and correct copy of the Driller's Log and Geological Tops to the best of my knowledge and belief.

WOODMAN & IANNITTI DRILLING CO.

By: K. T. Woodman
K. T. Woodman