

STATE OF KANSAS
STATE CORPORATION COMMISSION

Give All Information Completely
Make Required Affidavit
Mail or Deliver Report to
Conservation Division
State Corporation Comm.
245 North Water
Wichita, KS 67202

WELL PLUGGING RECORD

Ellis

County Wichita Twp. 14 Rge. 17 ~~W~~

Location as "NE/CNW $\frac{1}{2}$ SW $\frac{1}{2}$ " or from lines
NW SE NW

Lease Owner Dreiling Ltd. of Colorado

Lease Name Wasinger Well No. 1

Office Address 410 - 17th St., Denver, Colorado 80202

Character of Well (Completed as Oil, Gas or Dry Hole)
Dry Hole

Date Well completed December 3 1981

Application for plugging filed December 10 1981

Application for plugging approved January 4 1982

Plugging commenced December 3 12:30 A.M. 1981

Plugging completed December 3 2:00 A.M. 1981

Reason for abandonment of well or producing formation
Non-productive


If a producing well is abandoned, date of last production
None -1981

Was permission obtained from the Conservation Division or
its agents before plugging was commenced? Yes

Name of Conservation Agent who supervised plugging of this well Gilbert Scheck

Producing formation Depth to top Bottom Total Depth of Well 3618

Show depth and thickness of all water, oil and gas formations.

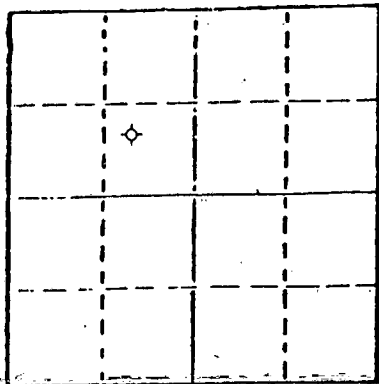

OIL, GAS OR WATER RECORDS

CASING RECORD

FORMATION	CONTENT	FROM	TO	SIZE	PUT IN	PULLED OUT
				8 5/8	206	NONE

Describe in detail the manner in which the well was plugged, indicating where the mud fluid was placed and the method or methods used in introducing it into the hold. If cement or other plugs were used, state the character of same and depth placed, from feet to feet for each plug set. Hole full of heavy mud-cement plugs with 50-50 regular

Portland and Pozmix 4% Gel 3% CCL pumped through drill pipe as follows:

- Plug at 720' with 70 sacks
- Plug at 210' with 40 sacks
- Plug at 40' with 10 sacks

- 10 sacks in rathole
- 5 sacks in mousehole

(If additional description is necessary, use BACK of this sheet)

Name of Plugging Contractor Halliburton

STATE OF Colorado COUNTY OF Denver, ss.
Les Olson (employee of owner) or (~~owner/operator~~)

of the above-described well, being first duly sworn on oath, says: That I have knowledge of the facts, statements, and matters herein contained and the log of the above-described well as filed and that the same are true and correct. So help me God.

(Signature) Les Olson
410 - 17th St., Suite 1140, Denver, Co. 80202
(Address)

SUBSCRIBED AND SWORN TO before me this 6th day of January, 19 82

Lorraine C. Murphy
Notary Public.

My commission expires

