

STATE OF KANSAS
STATE CORPORATION COMMISSION

Give All Information Completely
Make Required Affidavit
Mail or Deliver Report to:
Conservation Division
State Corporation Commission
212 North Market, Insurance Bldg.
Wichita, Kansas


Mail out

RP

15-051-00344-00-00

WELL PLUGGING RECORD

NORTH

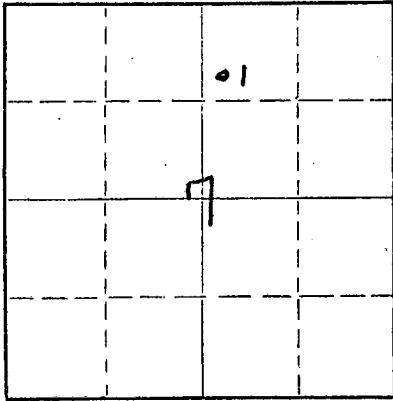

Locate well correctly on above
Section Plat

Ellis County. Sec. 7 Twp. 14 Rge. 17 (E) W (W)
Location as "NE/CNW/SW" or footage from lines SW/4 NW/4 NE/4
Lease Owner Davis Brothers
Lease Name Davis Bros. Younger Well No. A-1
Office Address 14 East 3rd St., Tulsa 3, Oklahoma.
Character of Well (completed as Oil, Gas or Dry Hole) _____
Date well completed 7-2 1959
Application for plugging filed 8-15 1960
Application for plugging approved 8-22 1960
Plugging commenced August 18 1960
Plugging completed Aug. 22 1960
Reason for abandonment of well or producing formation Well - Dry

If a producing well is abandoned, date of last production 6-30 1960
Was permission obtained from the Conservation Division or its agents before plugging was commenced? Yes.

Name of Conservation Agent who supervised plugging of this well Eldon Petty
Producing formation Arbuckle Depth to top 3550 Bottom 3565 Total Depth of Well 3565 Feet
Show depth and thickness of all water, oil and gas formations.

OIL, GAS OR WATER RECORDS

CASING RECORD

FORMATION	CONTENT	FROM	TO	SIZE	PUT IN	PULLED OUT
Arbuckle	oil	3550	3565	4 1/2	3553	2945'

Describe in detail the manner in which the well was plugged, indicating where the mud fluid was placed and the method or methods used in introducing it into the hole. If cement or other plugs were used, state the character of same and depth placed, from 3565 feet to surface feet for each plug set.

Pipe had been set at 3565, and cemented with 150 sacks of cement. No perforations. Hole filled with sand to 3540 feet; and four sacks of cement dumped in bottom of hole with dump bailer. All pipe then pulled from hole, and Halliburton pump trucks pumped down forty sacks of mud and 150 sacks of cement, forming cement plug to bottom of cellar.

Pipe had been shot off at 2945, and 165 feet of surface pipe left in hole.

RECEIVED
STATE CORPORATION COMMISSION
AUG 29 1960
08-29-60
CONSERVATION DIVISION
Wichita, Kansas

(If additional description is necessary, use BACK of this sheet)

Name of Plugging Contractor Barnes and Sons Pipe Pulling Co.,
Address Russell, Kansas.

STATE OF _____, COUNTY OF _____, ss.

_____ (employee of owner) or (owner or operator) of the above-described well, being first duly sworn on oath, says: That I have knowledge of the facts, statements, and matters herein contained and the log of the above-described well as filed and that the same are true and correct. So help me God.

(Signature) _____

(Address) _____

SUBSCRIBED AND SWORN TO before me this _____ day of _____, 19____

My commission expires _____

Notary Public.



15-051-00344-00-00

September 7, 1960

State Corporation Commission
Conservation Division
212 North Market
Wichita 2, Kansas

Re: Well log - Younger
A-1 SW NW NE - 7-14-17W
Ellis County, Kansas

WELL--LOG

Anhydrite
Heebner
Toronto
Lansing
Base KC
Arbuckle
TD

1218
3264
3282
3309
3535
3550
3565

RECEIVED
STATE CORPORATION COMMISSION
SEP 8 1960
CONSERVATION DIVISION
Wichita, Kansas

Yours very truly,

DAVIS BROS.

Ralph A. Hockenson
By: Ralph A. Hockenson
Manager of Production

RAH/rgr