


15-185-30002-00-00

WELL PLUGGING RECORD

Give All Information Completely
Make Required Affidavit
Mail or Deliver Report to:
Conservation Division
State Corporation Commission
211 No. Broadway
Wichita, Kansas

NORTH

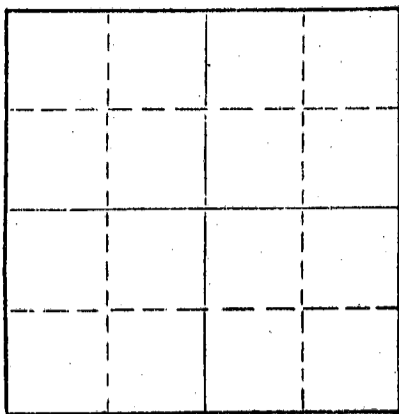

Locate well correctly on above
Section Plat

Stafford County, Sec. 5 Twp. 22S Rge. (E) 11 (W)
Location as "NE/CNWxSWx" or footage from lines C NE NW NE
Lease Owner Rains & Williamson Oil Co.
Lease Name FAIR "B" Well No. 1
Office Address 1425 Wichita Plaza, Wichita 2, Kansas
Character of Well (completed as Oil, Gas or Dry Hole) Dry Hole
Date well completed January 19 19 65
Application for plugging filed January 19 19 65
Application for plugging approved January 19 19 65
Plugging commenced January 19 19 65
Plugging completed January 19 19 65
Reason for abandonment of well or producing formation no oil or gas found
in commercial quantities.

If a producing well is abandoned, date of last production - - 19 -
Was permission obtained from the Conservation Division or its agents before plugging was commenced? Yes

Name of Conservation Agent who supervised plugging of this well Archie Elving, Pratt, Kansas
Producing formation _____ Depth to top _____ Bottom _____ Total Depth of Well 3540 Feet
Show depth and thickness of all water, oil and gas formations.

OIL, GAS OR WATER RECORDS

CASING RECORD

FORMATION	CONTENT	FROM	TO	SIZE	PUR IN	PULLED OUT
				8-5/8"	263'	None

Describe in detail the manner in which the well was plugged, indicating where the mud fluid was placed and the method or methods used in introducing it into the hole. If cement or other plugs were used, state the character of same and depth placed, from _____ feet to _____ feet for each plug set.

Set plug @ 240' with hulls & plug, cemented with 25 sacks cement thru drill pipe, Fluid @ 40', set solid bridge with hulls & plug, capped with 10 sacks cement.

RECEIVED
STATE CORPORATION COMMISSION

JAN 22 1965

1-22-65
CONSERVATION DIVISION
Wichita, Kansas

(If additional description is necessary, use BACK of this sheet)

Name of Plugging Contractor Rains & Williamson Oil Co.
Address 1425 Wichita Plaza, Wichita 2, Kansas

STATE OF KANSAS COUNTY OF SEDGWICK, ss.
Wilson Rains (owner or operator) of the above-described

well, being first duly sworn on oath, says: That I have knowledge of the facts, statements, and matters herein contained and the log of the above-described well as filed and that the same are true and correct. So help me God.

(Signature) Wilson Rains
Wilson Rains
1425 Wichita Plaza, Wichita 2, Kansas
(Address)

Subscribed and sworn to before me this 21th day of January, 19 65
Shirley Keck Notary Public.

My commission expires January 8, 1968



15-185-30002-00-00

ROTARY DRILLING LOG

Operator: Rains & Williamson Oil Co.
#1 Fair "B"
C NE NW NE Section 5-22S-11W
Stafford County, Kansas

Contractor: Rains & Williamson
Oil Co.
Commenced: 1-12-65
Completed: 1-19-65
Remarks: Set 263' 8-5/8" surface
casing with 260 sacks
cement.

FORMATION: *Bases*

Surface Soil & Sand	40'
Shale & Red Bed	483'
Anhydrite	498'
Shale & Shells	1135'
Shale & Lime Streaks	1552'
Lime & Shale	1870'
Shale & Lime	2740'
Shale	2864'
Lime & Shale	3116'
Lime	3490'
Simpson Shale	3508'
Chert & Lime	3516'
Arbuckle	3540'
Rotary Total Depth	3540'

RECEIVED
STATE CORPORATION COMMISSION

JAN 22 1965

CONSERVATION DIVISION
Wichita, Kansas

We certify the above log is true and correct to the best of our knowledge and belief.

RAINS & WILLIAMSON OIL CO.

Wilson Rains
Wilson Rains, Partner

Subscribed and sworn to before me, a Notary Public in and for the State of Kansas, County of Sedgwick, this 21th day of January, 1965.

My Commission Expires:
January 8, 1968

Shirley Keck
Shirley Keck, Notary Public

