


STATE OF KANSAS
STATE CORPORATION COMMISSION

15071-20146-0000

WELL PLUGGING RECORD

Give All Information Completely
Make Required Affidavit
Mail or Deliver Report to
Conservation Division
State Corporation Comm.
245 North Water
Wichita, KS 67202

Greeley County. Sec. 19 Twp. 18 Rge. 39 E/W
Location as "NE/CNW 1/4 SW 1/4" or footage from lines

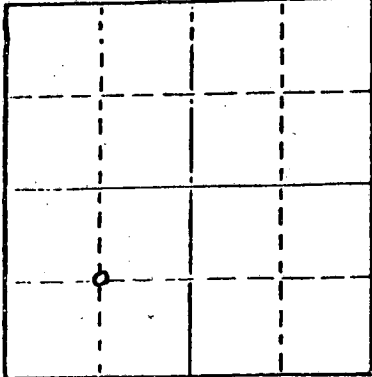

Locate well correctly on above
Section Plat

Lease Owner Dorchester Exploration Inc.
Lease Name Pringle "B" Well No. 1
Office Address 1100 Midland Nat'l Bk. Tower, Midland, Texas
Character of Well (Completed as Oil, Gas or Dry Hole) Gas

Date Well completed March 8 1978
Application for plugging filed 3-20 1978
Application for plugging approved 3-22 1978
Plugging commenced 3-28 1978
Plugging completed 3-29 1978

Reason for abandonment of well or producing formation Non Commercial Value
If a producing well is abandoned, date of last production 19
None

Was permission obtained from the Conservation Division or its agents before plugging was commenced? Yes

Name of Conservation Agent who supervised plugging of this well Mr. Balthazor
Producing formation Hugoton Depth to top 2882' Bottom 2895' Total Depth of Well 2990'
Show depth and thickness of all water, oil and gas formations.

OIL, GAS OR WATER RECORDS

CASING RECORD

FORMATION	CONTENT	FROM	TO	SIZE	PUT IN	PULLED OUT
Surface		0	219'	8 5/8"	219'	0'
Production		0'	2974'	4 1/2"	2974'	2175' 1361'

Describe in detail the manner in which the well was plugged, indicating where the mud fluid was placed and the method or methods used in introducing it into the hold. If cement or other plugs were used, state the character of same and depth placed, from _____ feet to _____ feet for each plug set.

Pumped 1 sack of hulls & 10 sacks cement to 2800' Pressured to 750 lbs.
Displaced w/ mud to 1000'
Pumped 25 sacks cement 1000' to 920'
Displaced w/ mud to 200'
Pumped 25 sacks cement 200' to 120'
Displaced w/ mud to 45'
Put bridge & 15 sacks cement 45' to 0'
Cut off 8 5/8" 42" below ground level.

RECEIVED
STATE CORPORATION COMMISSION
APR 05 1978
4-5-78

(If additional description is necessary, use BACK of this sheet)

Name of Plugging Contractor Midwest Casing Pulling
Box F, Sublette, Kansas 67877 Permit # 766

STATE OF KANSAS COUNTY OF Haskell, ss.
I Edgar J. Eves (employee of owner) or (owner or operator)
of the above-described well, being first duly sworn on oath, says: That I have knowledge of the facts, statements, and matters herein contained and the log of the above-described well as filed and that the same are true and correct. So help me God.

(Signature)

Edgar J. Eves
Box F, Sublette, Kansas 67877
(Address)

SUBSCRIBED AND SWORN TO before me this 29th day of March, 19 78

Londa L Eves

Notary Public.

My commission expires 12-6-80



15.071.20146.0000

GABBERT-JONES, INC.
WICHITA, KANSAS
DRILLERS' WELL LOG

Pringle 1-B
SW/4 Sec 19-18S-39W
Greeley County Kansas

Commenced: 12-29-77

Completed: 1-3-78

OPERATOR: DORCHESTER EXPLORATIONS, INC.

From	Depth to	Formation	Remarks
0	465	Sand-Blue Shale	Ran 5 jts of 24# 8 5/8" csg set @ 220' Cemented w/ 200 sks Class H - 30% CC 1/2# Flocele PD @ 7:00 p.m. 12-29-77
465	1539	Sand-Shale	
1539	2220	Shale	
2220	2425	Shale-Lime Stks	
2425	2975	Shale-Lime	
	2975 - TD		Ran 72 jts of 10 1/2# 4 1/2" csg set @ 2975' Cemented w/150 sks 50/50 Posmix - 10% Salt 3/4% CFR-2 PD @ 11:45 p.m. 1-2-77

STATE OF KANSAS)
) SS
COUNTY OF SEDGWICK)

I, the undersigned, being duly sworn on oath, state that the above Drillers' Well Log is true and correct to the best of my knowledge and belief and according to the records of this office.

GABBERT-JONES, INC.


JAMES S. SUTTON II

Subscribed and sworn to before me this 10th day of January, 1978.


ELIZABETH J. EDWARDS-NOTARY PUBLIC

My Commission expires February 6, 1979.

RECEIVED
STATE CORPORATION COMMISSION

MAR 22 1978

CONSERVATION DIVISION
Wichita, Kansas

