


WELL PLUGGING RECORD

Give All Information Completely
Make Required Affidavit
Mail or Deliver Report to:
Conservation Division
State Corporation Commission
800 Biting Building
Wichita, Kansas

Greeley County, Sec. 21 Twp. 18S Rge. 39 (E) 25 (W)

Location as "NE/CNW/SW" or footage from lines. NW SE
Lease Owner Caulkins Oil Company
Lease Name Fankhauser Well No. 1
Office Address 720 NW 50th St. Oklahoma City, Oklahoma
Character of Well (completed as Oil, Gas or Dry Hole) Dry Hole
Date well completed June 16 19 56
Application for plugging filed June 15 - Phone 19 56
Application for plugging approved June 15 - Phone 19 56
Plugging commenced June 15 19 56
Plugging completed June 16 19 56
Reason for abandonment of well or producing formation Dry Hole

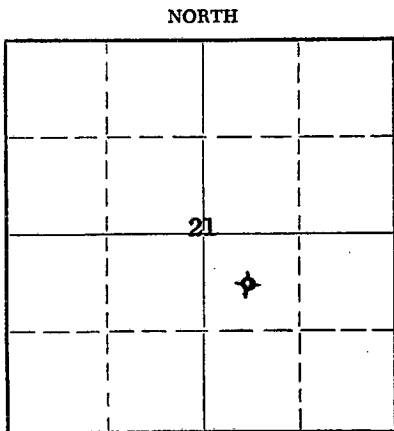

Locate well correctly on above Section Plat

If a producing well is abandoned, date of last production _____ 19____
Was permission obtained from the Conservation Division or its agents before plugging was commenced? Yes

Name of Conservation Agent who supervised plugging of this well R. M. Brundage, Hoisington, Kansas
Producing formation _____ Depth to top _____ Bottom _____ Total Depth of Well 5905' KB Feet
Show depth and thickness of all water, oil and gas formations.

OIL, GAS OR WATER RECORDS

CASING RECORD

| FORMATION | CONTENT | FROM | TO | SIZE | PUT IN | PULLED OUT |
|---------------------|---------|------|-------|------------|--------|------------|
| Surface Sand & Clay | | 0 | 420' | 13 3/8" OD | 418' | None |
| Clay, Shale, Gyp | | | | | | |
| Red Bed & Anhydrite | | 420' | 2610' | 8 5/8" OD | 2602' | 946' |
| | | | | | | |
| | | | | | | |
| | | | | | | |

Describe in detail the manner in which the well was plugged, indicating where the mud fluid was placed and the method or methods used in introducing it into the hole. If cement or other plugs were used, state the character of same and depth placed, from _____ feet to _____ feet for each plug set.

Set cement plug @ 2500' with 30 sacks cement, using Halliburton pump truck thru open end drill pipe. Set tap plug 30' below ground level with 20 sacks cement. Cement circulated to bottom of cellar. Plugging completed.

REL
STATE CORP
6-23-56
CONSERVATION DIVISION
Wichita, Kansas

(If additional description is necessary, use BACK of this sheet)

Name of Plugging Contractor R. W. Rine Drilling Company
Address 320 Central Building, Wichita, Kansas

STATE OF Kansas, COUNTY OF Sedgwick, ss. Agent for Operator
E. H. Slover (~~Employer or owner~~) or (~~owner or operator~~) of the above-described

well, being first duly sworn on oath, says: That I have knowledge of the facts, statements, and matters herein contained and the log of the above-described well as filed and that the same are true and correct. So help me God.

(Signature) CAULKINS OIL COMPANY
By E. H. Slover
Agent for Operator (Address)

SUBSCRIBED AND SWORN to before me this 22nd day of June 19 56

[Signature]
Notary Public.



My commission expires 6-14-58

24-7968-S 3-53-20M

PLUGGING
FILE SEC 21 T 18 R 39W
BOOK PAGE 71 LINE 32

NW SE
 Sec. 21-188-39W
 Greeley County, Kansas

15 071 00016 0000

FANKHAUSER NO. 1

CONTRACTOR: The R. W. Rine Drilling Co.

STARTED: May 26, 1956

COMPLETED: June 16, 1956

LOG

| | | | | |
|-------------------------|-------|---|-------|---------------------------------|
| Surface Sand & Clay | 0 | - | 420' | 13 3/8" csg @ 418' w/350. sx. |
| | | | | Syfo @ 200' 1/2°, @ 420' 1/2° |
| | | | | Syfo @ 905' 3/4° |
| Clay and Shale | 420' | - | 980' | |
| Sand & Shale | 980' | - | 1120' | |
| Shale & Gyp | 1120' | - | 1380' | |
| Gyp, Shale & Shells | 1380 | - | 1490' | Syfo @ 1460' 3/4° |
| Shale & Red Bed | 1490' | - | 1760' | Syfo @ 1760' 3/4° |
| Red Bed, Shale & Gyp | 1760' | - | 2375' | Syfo @ 2175' 3/4° |
| Shale & Anhydrite | 2375' | - | 2480' | |
| Anhydrite | 2480' | - | 2560' | |
| Shale & Anhydrite | 2560' | - | 2590' | |
| Shale, Anhydrite & Lime | 2590' | - | 2610' | 8 5/8" csg @ 2602' w/200 sx. |
| Red Bed & Lime | 2610' | - | 2910' | Syfo @ 2735' 1/2° |
| Lime & Shale | 2910' | - | 3350' | Syfo @ 3145' 1° |
| Lime | 3350' | - | 3545' | |
| Lime & Shale | 3545' | - | 3933' | Syfo @ 3600' 3/4°, @ 3930' 1° |
| Lime | 3933' | - | 4261' | Syfo @ 4100' 1/2° |
| Lime & Shale | 4261' | - | 4680' | Syfo @ 4400' 3/4°, @ 4800' 3/4° |
| Lime | 4680' | - | 4757' | |
| Lime & Shale & Chert | 4757' | - | 4815' | |
| Lime & Shale | 4815' | - | 4933' | Syfo @ 4860' 1/2° |
| Morrow & Shale | 4933' | - | 4994' | |
| Lime & Shale | 4994' | - | 5101' | Syfo @ 5050' 1° |
| Lime | 5101' | - | 5115' | |
| Lime & Shale | 5115' | - | 5170' | |
| Lime | 5170' | - | 5205' | |
| | | | TD | D & A |

STATE OF KANSAS)
) ss.
 COUNTY OF SEDGWICK)

I, R. M. Green, do hereby certify that the above is a true and accurate log of the FANKHAUSER WELL NO. 1, located NW SE, Section 21-188-39W, Greeley County, Kansas.

R. M. Green
 Ass't Secretary and Treasurer

Subscribed to and sworn before me this 22nd day of June, 1956.

STATE CORPORATION COMMISSION

JUN 23 1956

CONSERVATION DIVISION

John E. [Signature]
 Notary Public

My Commission Expires: 6-14-58 Wichita, Kansas

PLUGGING
 FILE SEC. 21 T. 18 R. 39W
 BOOK PAGE 71 LINE 32