15-071-20214-0000

FORM CP-4

STATE OF KANSAS
STATE CORPORATION COMMISSION

Give All Information Completely
Make Required Affidavit
Mail or Deliver Report to
Conservation Division
State Corporation Comm.
245 North Water
Wichita, KS 67202

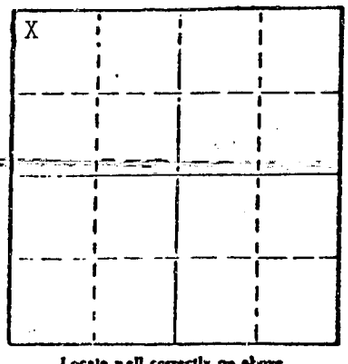

Locate well correctly on above Section Plat

WELL PLUGGING RECORD

Greeley County. Sec. ~~27~~ 31 Twp. ~~19~~ 18 Rge. ~~40~~ 39 E/W

Location as "NE/CNW¼SW¼" or footage from lines C NW NW NW

Lease Owner Bartling Oil Co.

Lease Name Bounds Well No. 1

Office Address 711 Polk Suite 730 Houston, Texas 77022

Character of Well (Completed as Oil, Gas or Dry Hole) Dry Hole

Date Well completed 10-25-80 1980

Application for plugging filed 10-26- 1980

Application for plugging approved 10-26- 1980

Plugging commenced A.M. 10-26-80 1980

Plugging completed 5 P.M. 10-26- 1980

Reason for abandonment of well or producing formation Dry Hole

If a producing well is abandoned, date of last production 19__

Was permission obtained from the Conservation Division or its agents before plugging was commenced? Yes

Name of Conservation Agent who supervised plugging of this well

Producing formation ____ Depth to top ____ Bottom ____ Total Depth of Well 2985'

Show depth and thickness of all water, oil and gas formations.

OIL, GAS OR WATER RECORDS

CASING RECORD

FORMATION	CONTENT	FROM	TO	SIZE	PUT IN	PULLED OUT
Surface	Clay-Sand	0	291	8 5/8"	291'	Left

Describe in detail the manner in which the well was plugged, indicating where the mud fluid was placed and the method or methods used in introducing it into the hold. If cement or other plugs were used, state the character of same and depth placed, from ____ feet to ____ feet for each plug set.

Spot 70 Sx. @ 1050'
20 Sx. @ 280'
10 Sx. @ 40'
5 Sx. Rathole

Completed by Howco @ 5:00 P.M. 10-26-80

(If additional description is necessary, use BACK of this sheet)

Name of Plugging Contractor Lakin Drilling Higginbottom Eng.

STATE OF Kansas COUNTY OF Seward, ss.

R. L. Higginbottom (employee of owner) or (owner or operator) of the above-described well, being first duly sworn on oath, says: That I have knowledge of the facts, statements, and matters herein contained and the log of the above-described well as filed and that the same are true and correct. So help me God.

(Signature) Robert L. Higginbottom

Box 6; Liberal, Kansas 67901
(Address)

SUBSCRIBED AND SWORN TO before me this 30th day of October, 1980

A. J. Parnell
Notary Public.

My commission expires 7-7-81

RECEIVED
STATE CORPORATION COMMISSION

A. J. PARNELL
Seward County, Kansas
My Appt. Exp. 7-7-81

OCT 31 1980
10-31-80
CONSERVATION DIVISION
Wichita, Kansas

15-071-20214-0000

CONTRACTOR'S WELL LOG

OPERATOR: Bartling Oil Co.
CONTRACTOR: Lakin Drilling Co.
WELL NAME: Bounds
LOCATION: ~~27-19-40~~ 31-18-39w
Greeley County, Kansas

GEOLOGIST:
SPUD DATE: 10-22-80
COMPLETION DATE: 10-26-80

FOOTAGE:

0	180	Clay & Sand
180	291	Shale
291	1225	Shale & Sand
1225	1850	Shale
1850	2200	Salt-Shale-Anhy
2200	2517	Shale & Sand
2517	2538	Anhy
2538	2830	Shale & Lime
2830	2985	Shale
	2985	T.D.

REPORT: Spud in @ 1:45 P.M. 10-22-80 12¼" Hole to 291'
Ran 7 Jts. 8 5/8" 20# Csg. 280' Set @ 291' Cement with
225 Sx. "H" 3% C.C. ¼# Flocele Plug down 7:45 P.M.
by Howco 10-22-80

Dry Hole
Plug with 70 Sx. @ 1050'
20 Sx. @ 280'
10 Sx. @ 40'
5 Sx. Rathole
Completed by Howco @ 5:00 P.M. 10-26-80

* * * * *

State of Kansas County of Kearny

Louis C Blankenship, Drilling Supt for Lakin Drilling Co, does hereby state that the above and foregoing is a true and correct copy of the log of the Bounds # 1 lease; 27-19-40 (legal); Greeley (county); Kansas.

LAKIN DRILLING COMPANY

By: L. C. Blankenship
Louis C Blankenship, Drilling Supt.

Subscribed and sworn to before me, a Notary Public, in and for the aforesaid county and state as of this 28th day of October, 19 80.

NINA M. WELLMAKER
NOTARY PUBLIC
Kearny County, Ks.

Nina M. Wellmaker
Notary Public

My Commission Expires: 6-15-81

RECEIVED
STATE CORPORATION COMMISSION
OCT 31 1980
CONSERVATION DIVISION
Wichita, Kansas