

15-071-20214-0000

Correction


STATE OF KANSAS
STATE CORPORATION COMMISSION

WELL PLUGGING RECORD

Give All Information Completely
Make Required Affidavit
Mail or Deliver Report to
Conservation Division
State Corporation Comm.
245 North Water
Wichita, KS 67202

Greeley County, Sec. 31 Twp. 18 Rge. 39 ~~X~~/W
Location as "NE/CNW $\frac{1}{4}$ SW $\frac{1}{4}$ " or footage from lines C NW NW

Lease Owner Bartling Oil Company
Lease Name Bounds Well No. 1
Office Address 711 Polk Suite 730 Houston, Texas 77022
Character of Well (Completed as Oil, Gas or Dry Hole) _____

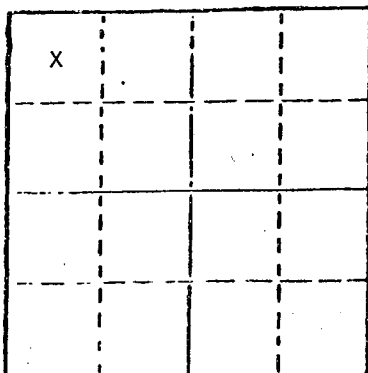

Dry hole
Date Well completed 10-25 1980
Application for plugging filed 10-26 1980
Application for plugging approved 10-26 1980
Plugging commenced A.M. 10-26 1980
Plugging completed 5:00 P.M. 10-26 1980
Reason for abandonment of well or producing formation _____

Dry Hole
If a producing well is abandoned, date of last production _____ 19____

Was permission obtained from the Conservation Division or its agents before plugging was commenced? Yes

Name of Conservation Agent who supervised plugging of this well _____
Producing formation _____ Depth to top _____ Bottom _____ Total Depth of Well 2985'
Show depth and thickness of all water, oil and gas formations.

OIL, GAS OR WATER RECORDS

CASING RECORD

FORMATION	CONTENT	FROM	TO	SIZE	PUT IN	PULLED OUT
Surface	Clay - Sd.	0	291	8 5/8"	291'	Left

Describe in detail the manner in which the well was plugged, indicating where the mud fluid was placed and the method or methods used in introducing it into the hold. If cement or other plugs were used, state the character of same and depth placed, from _____ feet to _____ feet for each plug set.

Spot - 70 Sx. @ 1050'
20 Sx. @ 280'
10 Sx. @ 40'
5 sx. Rathole

Completed by Howco @ 5:00 P.M. 10-26-80

RECEIVED
STATE CORPORATION COMMISSION
NOV - 7 1980
CONSERVATION DIVISION
Wichita, Kansas

(If additional description is necessary, use BACK of this sheet)

Name of Plugging Contractor Lakin Drilling Company - Higginbottom Eng.

STATE OF -KANSAS COUNTY OF SEWARD, ss.
R. L. Higginbottom (employee of owner) or (owner or operator)

of the above-described well, being first duly sworn on oath, says: That I have knowledge of the facts, statements, and matters herein contained and the log of the above-described well as filed and that the same are true and correct. So help me God.

(Signature) R. L. Higginbottom

Box 6; Liberal, Kansas 67901
(Address)

SUBSCRIBED AND SWORN TO before me this 6th day of November, 1980.

A. J. Parnell

Notary Public.

My commission expires

A. J. PARNELL
Seward County, Kansas
My Appt. Exp. 7-7-81.

CONTRACTOR'S WELL LOG

15-071-20214-0000

OPERATOR: Bartling Oil Co.
 CONTRACTOR: Lakin Drilling Co.
 WELL NAME: Bounds
 LOCATION: Sec. 31-18S-39W
Greeley County, Kansas

GEOLOGIST: _____
 SPUD DATE: 10-22-80
 COMPLETION DATE: 10-26-80

FOOTAGE:		
<u>0</u>	<u>180</u>	<u>Clay & Sand</u>
<u>180</u>	<u>291</u>	<u>Shale</u>
<u>291</u>	<u>1225</u>	<u>Shale & Sand</u>
<u>1225</u>	<u>1850</u>	<u>Shale</u>
<u>1850</u>	<u>2200</u>	<u>Salt-Shale-Anhy</u>
<u>2200</u>	<u>2517</u>	<u>Shale & Sand</u>
<u>2517</u>	<u>2538</u>	<u>Anhy</u>
<u>2538</u>	<u>2830</u>	<u>Shale & Lime</u>
<u>2830</u>	<u>2985</u>	<u>Shale</u>
<u> </u>	<u>2985</u>	<u>T.D.</u>
<u> </u>	<u> </u>	<u> </u>
<u> </u>	<u> </u>	<u> </u>
REPORT: Spud in @ 1:45 P.M. 10-22-80 12 1/4" Hole to 291'
Ran 7 Jts. 8 5/8" 20# Csg. 280' Set @ 291' Cement with
225 Sx. "H" 3/8 C.C. 1/4# Flocele Plug down 7:45 P.M.
by Howco 10-22-80

Dry Hole
Plug with 70 Sx. @ 1050'
20 Sx. @ 280'
10 Sx. @ 40'
5 Sx. Rathole

Completed by Howco @ 5:00 P.M. 10-26-80
 RECEIVED STATE CORPORATION COMMISSION
 CONSERVATION DIVISION
 Wichita, Kansas
 71980

State of Kansas County of Kearny
 Louis C Blankenship, Drilling Supt for Lakin Drilling Co, does hereby state that
 the above and foregoing is a true and correct copy of the log of the Bounds # 1
lease; 31-18S-39W (legal); Greeley (county); Kansas.

LAKIN DRILLING COMPANY
 By: Louis C Blankenship
Louis C Blankenship, Drilling Supt.

Subscribed and sworn to before me, a Notary Public, in and for the aforesaid county
 and state as of this 28th day of October, 1980.

NINA M. WELLMAKER
 NOTARY PUBLIC
 Kearny County, Ks.

Nina M. Wellmaker
 Notary Public

My Commission Expires: 6-15-81