


STATE OF KANSAS
STATE CORPORATION COMMISSION

Form CP-4

Give All Information Completely
Make Required Affidavit
Mail or Deliver Report to:
Conservation Division
State Corporation Commission

P. O. Box 17027
Wichita, Kansas 67217
NORTH

WELL PLUGGING RECORD

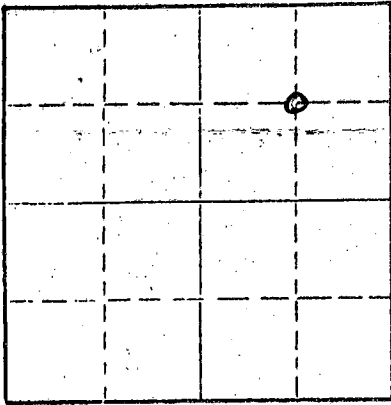

Locate well correctly on above
Section Plat

Greeley County, Sec. 33 Twp. 18S Rge. 39W XEX (XX)
Location as "NE/CNW%SW%" or footage from lines C NE/4
Lease Owner Dorchester Exploration, Inc.
Lease Name Hey Well No. 1
Office Address 1100 Midland Nat'l Bank Tower; Midland, Tx 79701
Character of Well (completed as Oil, Gas or Dry Hole) Dry Hole
Date well completed 6/18/77 19
Application for plugging filed 6/18/77 19
Application for plugging approved 19
Plugging commenced 6/18/77 19
Plugging completed 6/18/77 19
Reason for abandonment of well or producing formation Non-commercial

If a producing well is abandoned, date of last production _____ 19____
Was permission obtained from the Conservation Division or its agents before plugging was commenced? Yes

Name of Conservation Agent who supervised plugging of this well Leo F. Massey - Hays, Kansas
Producing formation Chase Depth to top 2885 Bottom 2982 Total Depth of Well 3010 Feet
Show depth and thickness of all water, oil and gas formations.

OIL, GAS OR WATER RECORDS

CASING RECORD

FORMATION	CONTENT	FROM	TO	SIZE	PUT IN	PULLED OUT
Winfield	Water	2885	2910	8-5/8"	279	None
Towanda	"	2910	2951			
Ft. Riley	"	2951	3010			

Describe in detail the manner in which the well was plugged, indicating where the mud fluid was placed and the method or methods used in introducing it into the hole. If cement or other plugs were used, state the character of same and depth placed, from _____ feet to _____ feet for each plug set.

Mud 3010' to 300'
Cement 40 sx 300' to 200'; mud 200' to 40'
Cement 10 sx 40 to surface
Cement 5 sx in Rat hole

RECEIVED
STATE CORPORATION COMMISSION

AUG 29 1977
8-29-77
CONSERVATION DIVISION
Wichita, Kansas

(If additional description is necessary, use BACK of this sheet)

Name of Plugging Contractor Halliburton Services
Address Duncan, Oklahoma

STATE OF KANSAS, COUNTY OF SEWARD, ss.
R. L. Higginbottom, Agent (employee of owner) or (owner or operator) of the above-described well, being first duly sworn on oath, says: That I have knowledge of the facts, statements, and matters herein contained and the log of the above-described well as filed and that the same are true and correct. So help me God.

(Signature) [Signature]
P. O. Box 6; Liberal, Ks. 67901
(Address)

Subscribed and Sworn to before me this 22nd day of August, 1977

My commission expires _____
A. J. PARNELL
Seward County, Kansas
My Appt. Exp. 7-7-81

Notary Public.

15-071-20134-0000

HIGGINBOTTOM ENGINEERING, INCORPORATED

P. O. BOX 6
LIBERAL, KANSAS 67901

316-624-3767

PETROLEUM ENGINEERING
PROPERTY MANAGEMENT

DRILLING & COMPLETIONS
WELL WORKOVERS

Well Log: Hey #1
C NE/4; Section 33-18S-39W
Greeley County, Kansas

Owner: Dorchester Exploration, Inc.
Rotary Contractor: Jim Snyder Drilling Company

Commenced: June 13, 1977
Completed: June 18, 1977

Total Depth: 3010'

0 - 285' Clay, Sand, Shale
285 - 750' Shale
750 - 1850' Shale, Lime, Sand
1850 - 2560' Salt, Shale, Lime, Anhydrite
2560 - 3010' Sand, Lime, Shale

Casing Record: Ran 6 jts. 8-5/8" new 24# casing (270.16'); set at 279'
w/ 200 sacks Class "H" cement - 3% CaCl. Cement
circulated to surface. Plug down 4:46 AM 6/14/77.

RECEIVED
STATE CORPORATION COMMISSION

AUG 29 1977

CONSERVATION DIVISION
Wichita, Kansas