


STATE OF KANSAS  
STATE CORPORATION COMMISSION

WELL PLUGGING RECORD

Give All Information Completely  
Make Required Affidavit  
Mail or Deliver Report to  
Conservation Division  
State Corporation Comm.  
245 North Water  
Wichita, KS 67202

Greeley County. Sec. 5 Twp. 18S Rge. 40W E/W  
Location as "NE/CNW $\frac{1}{4}$ SW $\frac{1}{4}$ " or footage from lines  
250' FSL & 330' FEL  
Lease Owner Smith Cattle Inc.  
Lease Name Smith Cattle Inc Well No. 5  
Office Address Box 399 Tribune, Kansas 67879  
Character of Well (Completed as Oil, Gas or Dry Hole) \_\_\_\_\_  
dry hole

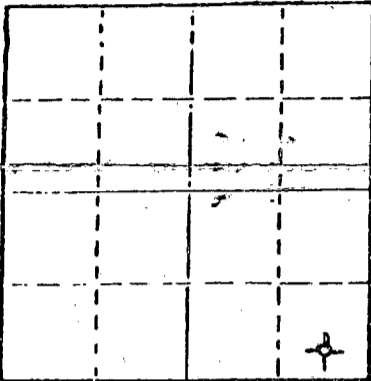

Locate well correctly on above  
Section Plot

Date Well completed May 23 1980  
Application for plugging filed \_\_\_\_\_ 19\_\_\_\_  
Application for plugging approved \_\_\_\_\_ 19\_\_\_\_  
Plugging commenced May 23 1980  
Plugging completed 7 am May 23 1980  
Reason for abandonment of well or producing formation \_\_\_\_\_  
non-productive  
If a producing well is abandoned, date of last production \_\_\_\_\_ 19\_\_\_\_

Was permission obtained from the Conservation Division or its agents before plugging was commenced? yes

Name of Conservation Agent who supervised plugging of this well Gilbert Balthazor  
Producing formation \_\_\_\_\_ Depth to top \_\_\_\_\_ Bottom \_\_\_\_\_ Total Depth of Well 3072'  
Show depth and thickness of all water, oil and gas formations.

OIL, GAS OR WATER RECORDS

CASING RECORD

FORMATION	CONTENT	FROM	TO	SIZE	PUT IN	PULLED OUT
				8 5/8"	260'	none

Describe in detail the manner in which the well was plugged, indicating where the mud fluid was placed and the method or methods used in introducing it into the hold. If cement or other plugs were used, state the character of same and depth placed, from \_\_\_\_\_ feet to \_\_\_\_\_ feet for each plug set.

- 70 sacks 50-50 pozmix with 6% gel at 1150'
- 20 sacks 50-50 pozmix with 6% gel at 260'
- wooden Halliburton plug at 40'
- 10 sacks 50-50 pozmix with 6% gel at 40'
- 5 sacks 50-50 pozmix with 6% gel in rathole
- 5 sacks 50-50 pozmix with 6% gel in mousehole

RECEIVED  
STATE CORPORATION COMMISSION  
JUN 4 1980  
6-4-80  
CONSERVATION DIVISION  
Wichita, Kansas

(If additional description is necessary, use BACK of this sheet)

Name of Plugging Contractor Halliburton

STATE OF Kansas COUNTY OF Greeley, ss.  
OWNER (employee of owner) or (owner or operator)  
of the above-described well, being first duly sworn on oath, says: That I have knowledge of the facts, statements, and matters herein contained and the log of the above-described well as filed and that the same are true and correct. So help me God.

(Signature)

Joe D. Smith  
Tribune, Kansas 67879  
(Address)

SUBSCRIBED AND SWORN TO before me this 3rd day of June, 1980

My commission expires

March 7th 1981

Wayne D. Stepher  
Notary Public.

