


STATE OF KANSAS  
STATE CORPORATION COMMISSION

Give All Information Completely  
Make Required Affidavit  
Mail or Deliver Report to:  
Conservation Division  
State Corporation Commission  
P. O. Box 17027  
Wichita, Kansas 67217  
NORTH

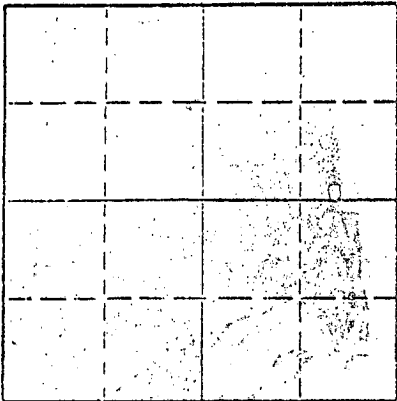

Locate well correctly on above  
Section Plat

15-167-20566-00-00

Form CP-4

WELL PLUGGING RECORD

Russell County. Sec. 2 Twp. 14S Rge. 11W (E) (W) X  
Location as "NE/CNW/SW" or footage from lines. SW SE SE  
Lease Owner Albert W. Borell  
Lease Name Gable-Ringer Well No. 1  
Office Address Box 391, Wilson, Kansas  
Character of Well (completed as Oil, Gas or Dry Hole) D&A  
Date well completed September 27 1972  
Application for plugging filed September 27 1972  
Application for plugging approved September 27 1972  
Plugging commenced September 27 1972  
Plugging completed September 27 1972  
Reason for abandonment of well or producing formation D&A  
If a producing well is abandoned, date of last production 19  
Was permission obtained from the Conservation Division or its agents before plugging was commenced? yes

Name of Conservation Agent who supervised plugging of this well Donald Truan  
Producing formation Depth to top Bottom Total Depth of Well 3460 Feet  
Show depth and thickness of all water, oil and gas formations.

OIL, GAS OR WATER RECORDS

CASING RECORD

| FORMATION | CONTENT | FROM | TO | SIZE   | PUT IN | PULLED OUT |
|-----------|---------|------|----|--------|--------|------------|
|           |         |      |    | 8-5/8" | 347'   | -0-        |
|           |         |      |    |        |        |            |
|           |         |      |    |        |        |            |
Describe in detail the manner in which the well was plugged, indicating where the mud fluid was placed and the method or methods used in introducing it into the hole. If cement or other plugs were used, state the character of same and depth placed, from feet to feet for each plug set.

Plugged @ 480' w/40 sx, plugged  
@ 320' w/25 sx, plugged @ 40'  
w/1/2 sx hulls, 10 sx to bottom  
collar.

RECEIVED  
STATE CORPORATION COMMISSION  
OCT 24 1972  
CONSERVATION DIVISION  
Wichita, Kansas  
10-24-72

(If additional description is necessary, use BACK of this sheet)  
Name of Plugging Contractor Red Tiger Drilling Company  
Address 1720 Wichita Plaza, Wichita, Kansas 67202

STATE OF Kansas, COUNTY OF Sedgwick ss.  
Virginia K. Albert (employee of owner) or (owner or operator) of the above-described  
being first duly sworn on oath, says: That I have knowledge of the facts, statements, and matters herein contained and the log of the  
above-described well and that the same are true and correct. So help me God.

(Signature) Virginia K. Albert  
1720 Wichita Plaza, Wichita, Kansas 67202  
(Address)

Subscribed and sworn to before me this 2nd day of October, 1972

My commission expires July 25, 1976.

Notary Public.

15-167-20566-00-00

DRILLERS LOG

No. 1 Gable-Binger

CASING RECORD:

8-5/8" @ 347'  
w/200 sx cement

TOTAL DEPTH: 3460'

COMPANY:

Albert W. Borell

CONTRACTOR: Red Tiger Drilling Company

COMMENCED: September 19, 1972

COMPLETED: September 27, 1972

DESCRIPTION:

SW SE SE  
2-14S-11W  
Russell County,  
Kansas

ELEVATION:

FORMATION

FROM

TO

REMARKS


|                  |      |      |
|------------------|------|------|
| Clay & Post Rock | 0    | 55   |
| Sand & Shale     | 55   | 652  |
| Anhydrite        | 652  | 679  |
| Shale - Redbed   | 679  | 745  |
| Shale & Shells   | 745  | 1350 |
| Shale & Lime     | 1350 | 2720 |
| Lime             | 2720 | 3350 |
| Lime & Arbuckle  | 3350 | 3415 |
| Lime             | 3415 | 3460 |

RECEIVED  
STATE CORPORATION COMMISSION  
OCT 6 1972  
CONSERVATION DIVISION  
Wichita, Kansas

I certify that this is a true and correct copy of the above log to the best of my knowledge.

RED TIGER DRILLING COMPANY

Virginia K. Albert  
Virginia K. Albert

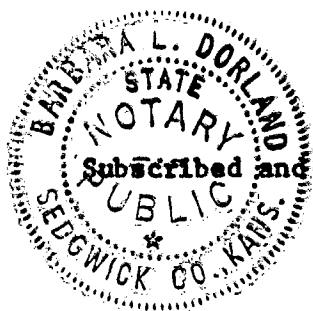

Subscribed and sworn to before me this 2nd day of October, 1972.

Barbara L. Dorland  
Notary Public

My commission expires:  
July 25, 1976