


STATE OF KANSAS
STATE CORPORATION COMMISSION

15-167-00511-00-00
WELL PLUGGING RECORD

Give All Information Completely
Make Required Affidavit
Mail or Deliver Report to:
Conservation Division
State Corporation Commission
212 North Market, Insurance Bldg.
Wichita, Kansas

Russell County, Sec. 34 Twp. 14 Rge. ~~35~~ 15 (W)

NORTH

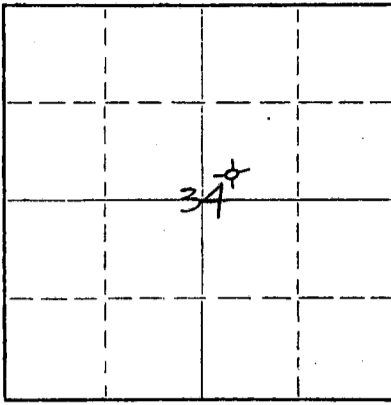

Locate well correctly on above
Section Plat

Location as "NE/CNW/SW" or footage from lines SW SW NE
Lease Owner Icer Addis
Lease Name Joe Witt Well No. 1
Office Address Box 519 Great Bend, Kansas
Character of Well (completed as Oil, Gas or Dry Hole) dry hole
Date well completed Feb. 24 19 61
Application for plugging filed Feb. 28 19 61
Application for plugging approved _____ 19 _____
Plugging commenced Feb. 24 19 61
Plugging completed " " 19 61
Reason for abandonment of well or producing formation dry hole

If a producing well is abandoned, date of last production _____ 19 _____
Was permission obtained from the Conservation Division or its agents before plugging was commenced? yes

Name of Conservation Agent who supervised plugging of this well Mr. Don Truan
Producing formation _____ Depth to top _____ Bottom _____ Total Depth of Well 3400 Feet
Show depth and thickness of all water, oil and gas formations.

OIL, GAS OR WATER RECORDS

CASING RECORD

FORMATION	CONTENT	FROM	TO	SIZE	PUT IN	PULLED OUT
				8 5/8"	229'	none

Describe in detail the manner in which the well was plugged, indicating where the mud fluid was placed and the method or methods used in introducing it into the hole. If cement or other plugs were used, state the character of same and depth placed, from _____ feet to _____ feet for each plug set.

Bottom plug at 200', 1/2 sack of hulls and 25 sacks of cement, top plug at 35', 1/2 sack of hulls and 10 sacks of cement. 2 sacks of cement in rathole.

STATE CORPORATION COMMISSION
MAR 6 1961 03-06-61
CONSERVATION DIVISION
Wichita, Kansas

(If additional description is necessary, use BACK of this sheet)
Name of Plugging Contractor Triangle Drilling, Inc.
Address Box 519 Great Bend, Kansas

STATE OF Kansas, COUNTY OF Barton, ss.
Donald D. Vaughan (employee of owner) or (owner or operator) of the above-described well, being first duly sworn on oath, says: That I have knowledge of the facts, statements, and matters herein contained and the log of the above-described well as filed and that the same are true and correct. So help me God.

(Signature) Donald D. Vaughan
Donald D. Vaughan
Box 619 Great Bend, Kansas (Address)
February 28th, 1961

SUBSCRIBED AND SWORN to before me this _____ day of _____, 1961
My commission expires July 1, 1964

Jessie Lee Dunn
Jessie Lee Dunn, Notary Public.



WELL LOG

COMPANY Icer Addis
 CONTRACTOR Triangle Drilling, Inc.
 FARM #1 Joe Witt
 LOCATION SW SW NE of Section 34-14-15W
 Russell County, Kansas
 ELEVATION 1881 KB
 SURFACE PIPE 8 5/8" cemented @ 229* w/150 sacks Pozmix Sunset cement
 PRODUCTION D & A
 COMMENCED 2-16-61
 COMPLETED 2-24-61

<u>FORMATION</u>	<u>DEPTH</u>
Clay and sand	20
Post rock and shale	60
Shale and sand	180
Shale	260
Shale and sand streaks	326
Shale and sand	375
Sand	445
Shale and sand streaks	470
Sand	565
Red bed	932
Anhydrite	971
Shale and shells	1560
Lime and shale	2822
Limestone	3075
Shale	3100
Limestone	3336
Chert Conglomerate	3396
Dolomite	3400

RECEIVED
 STATE CORPORATION COMMISSION

FEB 26 1961
 CONSERVATION DIVISION
 Wichita, Kansas

FORMATION TOPS

Anhydrite	932 (✓ 949) driller's
Topeka	2822 (- 941)
Heebner	3041 (-1160)
Toronto	3060 (-1179)
Lansing	3100 (-1219)
Chert Conglomerate	3336 (-1455)
Arbuckle	3396 (-1515)
RTD	3400 (-1519)

A F F I D A V I T


STATE OF KANSAS, COUNTY OF BARTON, SS.

I, Donald D. Vaughan, Petroleum Geologist, being first duly sworn on oath, state; That I have knowledge of the facts, statements and matters herein contained and that the same are true and correct.

Donald D. Vaughan
 Donald D. Vaughan

Subscribed and sworn to before me this 28th day of February, 1961.

Donna Lea Foelgher
 Donna Lea Foelgher
 Notary Public

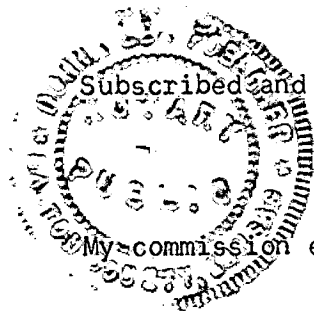

My commission expires: May 11, 1963.