


Give All Information Completely  
Make Required Affidavit  
Mail or Deliver Report to:  
Conservation Division  
State Corporation Commission  
211 No. Broadway  
Wichita, Kansas

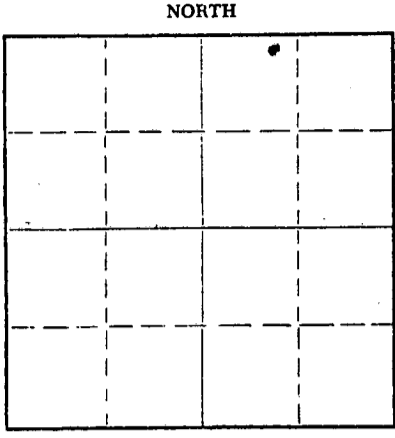

Locate well correctly on above Section Plat

Russell County, Sec. 34 Twp. 14 Rge. 14 (E) W (W)

Location as "NE/CNW/SW" or footage from lines NE NW NE  
 Lease Owner Mary A. Herman  
 Lease Name Witt Well No. 1  
 Office Address Box 348 Russell, Kansas  
 Character of Well (completed as Oil, Gas or Dry Hole) Dry hole  
 Date well completed 8-30 19 66  
 Application for plugging filed 8-30 19 66  
 Application for plugging approved 8-30 19 66  
 Plugging commenced 8-30 19 66  
 Plugging completed 8-30 19 66  
 Reason for abandonment of well or producing formation Dry hole

If a producing well is abandoned, date of last production 19  
 Was permission obtained from the Conservation Division or its agents before plugging was commenced? yes

Name of Conservation Agent who supervised plugging of this well Don Traug  
 Producing formation \_\_\_\_\_ Depth to top \_\_\_\_\_ Bottom \_\_\_\_\_ Total Depth of Well 3345 Feet  
 Show depth and thickness of all water, oil and gas formations.

OIL, GAS OR WATER RECORDS

CASING RECORD

FORMATION	CONTENT	FROM	TO	SIZE	PUT IN	PULLED OUT

Describe in detail the manner in which the well was plugged, indicating where the mud fluid was placed and the method or methods used in introducing it into the hole. If cement or other plugs were used; state the character of same and depth placed, from 3345 feet to 180 feet for each plug set.  
Plug @ 180' 25 sks. cement fill hole to 40'  
1/2 sk. hulls, 10 sks. cement, 2 sks. cement in rathole.

RECEIVED  
STATE CORPORATION COMMISSION  
SEP 6 1966  
CONSERVATION DIVISION


(If additional description is necessary, use BACK of this sheet)

Name of Plugging Contractor German Drilling Company  
 Address 502 Petroleum Building

STATE OF Kansas, COUNTY OF Sedgwick, ss.  
Harvey F. German (employee of owner) or (owner or operator) of the above-described well, being first duly sworn on oath, says: That I have knowledge of the facts, statements, and matters herein contained and the log of the above-described well as filed and that the same are true and correct. So help me God.

(Signature) Harvey F. German  
502 Petroleum Building  
 (Address)

SUBSCRIBED AND SWORN to before me this 1st day of September, 19 66  
Geneva M. German  
 Geneva M. German Notary Public.  
 My commission expires 2-28-68

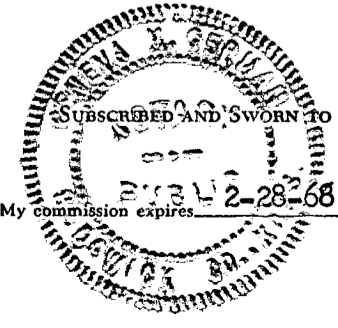

OPERATOR: Mary A. Herman  
Box 348  
Russell, Kansas

LOCATION: Well # 1  
NE NW NE  
34-14-14 SW  
Russell County,  
Kansas

CONTRACTOR: German Drilling Company  
502 Petroleum Building  
Wichita, Kansas 67202

Farm: Witt - Well No. 1  
Date Commenced: 8-14-66 -  
Date Completed: 8-30-66 - Rotary

From	To	Formation
0	75	Rost Rock & Clay
75	125	Sand & Clay
125	195	Shale
195	440	Shale
440	650	Sand & Shale
650	910	Red Bed & Shale Shad
910	946	Anhydrite
946	1100	Shale
1000	1615	Shale
1615	1668	Shale-Lime Stks.
1668	1945	Lime & Shale
1945	2045	Lime
2045	2138	Lime
2138	2220	Lime & Shale
2220	2350	Shale & Lime
2350	2425	Shale & Lime
2425	2565	Shale & Lime
2565	2690	Shale & Lime
2690	2775	Shale & Lime
2775	2830	Lime
2830	2940	Lime & Shale
2940	2986	Lime & Shale
2986	3018	Lime
3018	3130	Lime
3130	3184	Lime
3184	3232	Lime
3232	3270	K.C. Lime
3270	3330	Lime
3330	3345	Lime
3345		K.C. Lime
		TD

I hereby certify that the foregoing is a true and correct copy of the Well Log for the Witt #1, drilled for Mary A. Herman, and completed August 30, 1966.

RECEIVED GERMAN DRILLING COMPANY  
STATE CORPORATION COMMISSION

SEP 6 1966

Harvey F. German

STATE OF KANSAS }  
COUNTY OF SEDGWICK } ss.

CONSERVATION DIVISION  
Wichita, Kansas

Subscribed and sworn to, before the undersigned, A Notary Public, in and for County and State aforesaid, this first day of September, 1966.

Geneva M. German - Notary Public

My commission expires February 28, 1968.