


STATE OF KANSAS
STATE CORPORATION COMMISSION

15-167-21919-0000

WELL PLUGGING RECORD

Give All Information Completely
Make Required Affidavit
Mail or Deliver Report to
Conservation Division
State Corporation Comm.
245 North Water
Wichita, KS 67202

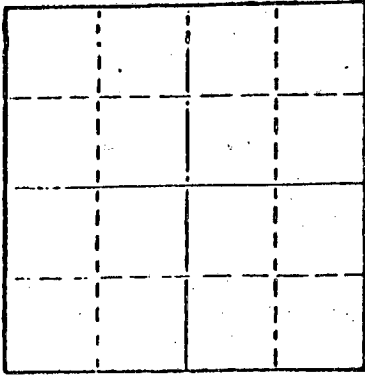

Russell County. Sec. 7 Twp. 14 Rge. 15 E/W
Location as "NE/CNW $\frac{1}{4}$ SW $\frac{1}{4}$ " or footage from lines
SW $\frac{1}{4}$

Lease Owner Crude Producers Inc.
Lease Name Zedja Well No. #1
Office Address Box 55 Russell, Kansas 67665
Character of Well (Completed as Oil, Gas or Dry Hole)
Dry Hole

Date Well completed 5-23- 1982
Application for plugging filed 5-23- 1982
Application for plugging approved 5-23- 1982
Plugging commenced 5-23 10:30 am 1982
Plugging completed 5-23 1:30 pm 1982
Reason for abandonment of well or producing formation
Dry Hole

If a producing well is abandoned, date of last production
19

Was permission obtained from the Conservation Division or
its agents before plugging was commenced? yes

Name of Conservation Agent who supervised plugging of this well Gilbert Scheck

Producing formation Depth to top Bottom Total Depth of Well 3420'

Show depth and thickness of all water, oil and gas formations.

8 5/8 set @ 215'

OIL, GAS OR WATER RECORDS						CASING RECORD	
FORMATION	CONTENT	FROM	TO	SIZE	PUT IN	PULLED OUT	

Describe in detail the manner in which the well was plugged, indicating where the mud fluid
was placed and the method or methods used in introducing it into the hold. If cement or other
plugs were used, state the character of same and depth placed, from feet to
feet for each plug set.

Filled hole to 720' with heavy mud and mixed 70 sacks of cement and pumped in hole thru drill
pipe.

Filled hole to 250' with heavy mud and mixed 40 sacks of cement and pumped in hole thru drill
pipe.

Filled hole to 40' built bridge pushed down plug and mixed 10 sacks of cement and filled hole
to bottom of cellar; mixed 10 sacks and poured into the rat hole.

All cement used was 50-50 Pox Mix 4% Gel 3% CC

(If additional description is necessary, use BACK of this sheet)

Name of Plugging Contractor Revlin Drlg., Inc.

STATE OF Kansas COUNTY OF Russell, ss.
Stanley C. Lingreen (employee of owner) or (owner or operator)
of the above-described well, being first duly sworn on oath, says: That I have knowledge of
the facts, statements, and matters herein contained and the log of the above-described well
as filed and that the same are true and correct. So help me God.



(Signature) Stanley C. Lingreen
Box 293 Russell, Kansas 67665
(Address)

SUBSCRIBED AND SWORN TO before me this 25th day of May, 1982

Paula J. Gibson
Notary Public.

My commission expires November 10, 1984

RECEIVED
STATE CORPORATION COMMISSION

JUN - 4 1982

CONSERVATION DIVISION
Wichita, Kansas