

15-109-20138-00-00


STATE OF KANSAS  
STATE CORPORATION COMMISSION

Form CP-4

WELL PLUGGING RECORD

Give All Information Completely  
Make Required Affidavit  
Mail or Deliver Report to:  
Conservation Division  
State Corporation Commission  
211 No. Broadway  
Wichita, Kansas

NORTH

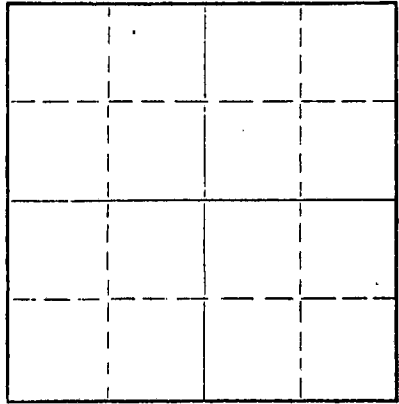

Locate well correctly on above  
Section Plat

Logan County, Sec. 9 Twp. 14S Rge. 32W (E) (W)  
Location as "NE/CNW/SW" or footage from lines C NE SW  
Lease Owner Thunderbird Drilling, Inc.  
Lease Name Steele Estate "B" Well No. 1  
Office Address P.O. Box 18407- Wichita, Kansas 67218  
Character of Well (completed as Oil, Gas or Dry Hole) Dry Hole  
Date well completed 11/3/79 19  
Application for plugging filed 11/3/79 19  
Application for plugging approved 11/3/79 19  
Plugging commenced 11/3/79 19  
Plugging completed 11/3/79 19  
Reason for abandonment of well or producing formation Dry Hole

If a producing well is abandoned, date of last production 19  
Was permission obtained from the Conservation Division or its agents before plugging was commenced? Yes

Name of Conservation Agent who supervised plugging of this well Gilbert Balthazor  
Producing formation \_\_\_\_\_ Depth to top \_\_\_\_\_ Bottom \_\_\_\_\_ Total Depth of Well 4550 Feet  
Show depth and thickness of all water, oil and gas formations.

OIL, GAS OR WATER RECORDS

CASING RECORD

FORMATION	CONTENT	FROM	TO	SIZE	PUT IN	PULLED OUT
	Surface	0	330'	8 5/8"		None

Describe in detail the manner in which the well was plugged, indicating where the mud fluid was placed and the method or methods used in introducing it into the hole. If cement or other plugs were used, state the character of same and depth placed, from \_\_\_\_\_ feet to \_\_\_\_\_ feet for each plug set.

1st plug @ 1450' w/70 sx  
2nd plug @ 300' w/20 sx  
3rd plug @ 40' w/10 sx

RECEIVED  
STATE CORPORATION COMMISSION  
NOV 20 1979  
CONSERVATION DIVISION  
Wichita, Kansas

(If additional description is necessary, use BACK of this sheet)  
Name of Plugging Contractor THUNDERBIRD DRILLING, INC.  
Address P.O. Box 18407- Wichita, Kansas 67218

STATE OF KANSAS, COUNTY OF SEDGWICK, ss.  
Burke Krueger (employee of owner) or (owner or operator) of the above-described

well, being first duly sworn on oath, says: That I have knowledge of the facts, statements, and matters herein contained and the log of the above-described well as filed and that the same are true and correct. So help me God.

(Signature) Burke Krueger  
P.O. Box 18407- Wichita, Ks. 67218  
(Address)

SUBSCRIBED AND SWORN TO before me this 16th day of November, 19 79

My commission expires 3-25-80

Gloria DeJesus  
Gloria DeJesus Notary Public.



15-109-20138-00-00

DRILLERS LOG

Company Thunderbird Drilling, Inc.

Contractor Thunderbird Drilling, Inc

Elevation 2840' K.B.

Farm Steele Estate "B"

Well No. 1

Casing 8 5/8" @ 330' w/275 sx

Location C NE SW, Sec. 9-14S-32W

County Logan County, Kansas

Production None

<u>From</u>	<u>To</u>	<u>Description</u>
0	330	Surface Hole
330	1290	Sand
1290	1816	Shale & Sand
1816	2304	Shale & Shells
2304	2350	Anhydrited
2350	2490	Shale & Shells
2490	2675	Lime & Shale
2675	2977	Shale
2977	3200	Lime & Shale
3200	3345	Shale & Lime
3345	3485	Lime & Shale
3485	3620	Shale & Lime
3620	3995	Lime & Shale
3995	4550	Lime
4550	R.T.D.	

STATE OF KANSAS )  
                          ) ss.  
COUNTY OF SEDGWICK)

RECEIVED  
STATE CORPORATION COMMISSION

NOV 20 1979

CONSERVATION DIVISION  
Wichita, Kansas

I, Burke Krueger, of Thunderbird Drilling, Inc. upon oath states that the above and foregoing is a true and correct copy from the Daily Drilling Report from your Steele Estate "B" #1.

Burke Krueger

Subscribed and sworn to before me this 16th day of November, 1979

Gloria DeJesus  
Gloria DeJesus Notary Public

My commission expires: 3-25-80

