


Give All Information Completely  
Make Required Affidavit  
Mail or Deliver Report to:  
Conservation Division  
State Corporation Commission  
212 North Market, Insurance Bldg.  
Wichita, Kansas

WELL PLUGGING RECORD

Logan County. Sec. 34 Twp. 14S Rge. 35 (XX) (W)

Location as "NE/CNW/SW" or footage from lines C NW NE  
Lease Owner Glenn W. Peel Drilling Company  
Lease Name Haverfield-Ware Well No. 1  
Office Address R. R. #3, Box 144B, Wichita 20, Kansas  
Character of Well (completed as Oil, Gas or Dry Hole) Dry Hole  
Date well completed 12-24 19 60  
Application for plugging filed 12-24 19 60  
Application for plugging approved 12-24 19 60  
Plugging commenced 12-24 19 60  
Plugging completed 12-24 19 60  
Reason for abandonment of well or producing formation Dry Hole

NORTH

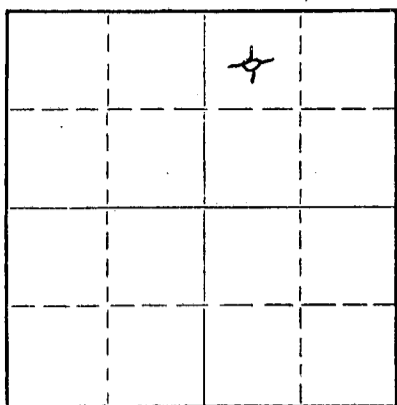

Locate well correctly on above Section Plat

If a producing well is abandoned, date of last production \_\_\_\_\_ 19\_\_\_\_  
Was permission obtained from the Conservation Division or its agents before plugging was commenced? Yes

Name of Conservation Agent who supervised plugging of this well Gilbert P. Leiker  
Producing formation \_\_\_\_\_ Depth to top \_\_\_\_\_ Bottom \_\_\_\_\_ Total Depth of Well 4669 Feet  
Show depth and thickness of all water, oil and gas formations.

OIL, GAS OR WATER RECORDS

CASING RECORD

FORMATION	CONTENT	FROM	TO	SIZE	PUT IN	PULLED OUT
		0	162	8 5/8"	162	None

Describe in detail the manner in which the well was plugged, indicating where the mud fluid was placed and the method or methods used in introducing it into the hole. If cement or other plugs were used, state the character of same and depth placed, from \_\_\_\_\_ feet to \_\_\_\_\_ feet for each plug set.

- From 4669' to 163 1/2' - Heavy Rotary Mud
- " 163 1/2' to 162' - Wooden Plug
- " 162' to 100' - 20 sacks cement
- " 100' to 41 1/2' - Heavy Rotary Mud
- " 41 1/2' to 40' - Wooden Plug
- " 40' to 6' - 10 sacks cement
- " 6' to surface - Cellar


RECEIVED  
STATE CORPORATION COMMISSION  
JAN 6 1961  
CONSERVATION DIVISION  
Wichita, Kansas

(If additional description is necessary, use BACK of this sheet)

Name of Plugging Contractor \_\_\_\_\_  
Address \_\_\_\_\_

STATE OF SEDGWICK COUNTY OF KANSAS, ss.  
William Herbert (employee of owner) or (owner or operator) of the above-described well, being first duly sworn on oath, says: That I have knowledge of the facts, statements, and matters herein contained and the log of the above-described well as filed and that the same are true and correct. So help me God.

(Signature) Wm Herbert  
R. R. #3, Box 144B, Wichita 20, Kansas  
(Address)

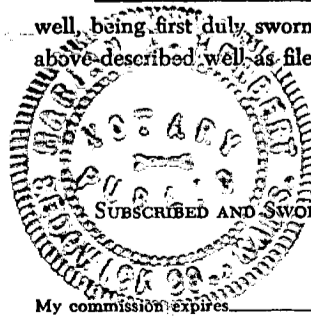

SUBSCRIBED AND SWORN TO before me this 3 day of January, 19 61  
Marjorie M. Herbert Notary Public.  
My commission expires March 4, 1962

DRILLER'S LOG

Company: Glenn W. Peel Drilling Co.  
Farm: Haverfield-Ware Well No. 1  
Total Depth: 4669'  
Comm.: 12-10-60 Comp.: 12-24-60  
Contractor: Glenn W. Peel Drilling Co.  
Casing: 8 5/8" @ 162' cem.

Location: CNW NE  
Sec. 34, Twp.: 14S, Rge. 35W,  
County: Logan,  
Kansas  
Elevation:  
Production: Dry

Figures below indicate bottom of formations

Surface clay	0 -	40'
Shale		1360
Shale & shells w/sand streaks		1542
Anhydrite		1575
Shale		1705
Anhydrite		1730
Shale		2020
Shale & shells		2230
Shale		2374
Anhydrite		2397
Red bed		2485
Shale w/lime streaks		2740
Shale		2820
Shale & lime		3225
Lime		3385
Lime & shale		3555
Lime		3630
Lime & shale		3825
Lime		4295
Lime & chert		4355
Lime		4420
Lime w/shale streaks		4465
Lime		4669
Total Depth		4669

RECEIVED  
STATE CORPORATION COMMISSION  
JAN 6 1961  
CONSERVATION DIVISION  
Wichita, Kansas

This is to certify that the above information is to the best of my knowledge true and correct.

GLENN W. PEEL DRILLING COMPANY

BY: Way Herbert

SUBSCRIBED AND SWORN TO before me this 3<sup>rd</sup> day of January, 1961

My commission expires March 4, 1962.

Marian M. Herbert  
Notary Public

