

15-109-00035-00-00


STATE OF KANSAS
STATE CORPORATION COMMISSION

Give All Information Completely
Make Required Affidavit
Mail or Deliver Report to:
Conservation Division
State Corporation Commission
212 North Market, Insurance Bldg.
Wichita, Kansas

WELL PLUGGING RECORD

Logan County. Sec. 23 Twp. 14S Rge. (E) 34 (W)

Location as "NE/CNW/SW" or footage from lines SW SW
Lease Owner Arvel C. Smith
Lease Name Hawes Well No. 1
Office Address 569 Stratford Road, Wichita 6, Kansas
Character of Well (completed as Oil, Gas or Dry Hole) Dry Hole
Date well completed February 19, 19 62
Application for plugging filed February 19, 19 62
Application for plugging approved " " 19 "
Plugging commenced " " 19 "
Plugging completed " " 19 "
Reason for abandonment of well or producing formation Dry Hole

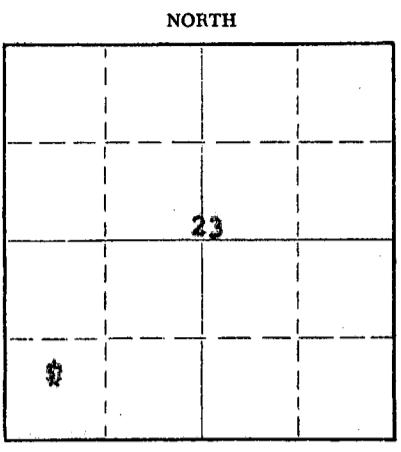

Locate well correctly on above
Section Plat

If a producing well is abandoned, date of last production 19
Was permission obtained from the Conservation Division or its agents before plugging was commenced? Yes

Name of Conservation Agent who supervised plugging of this well Mr. Eldon Petty
Producing formation _____ Depth to top _____ Bottom _____ Total Depth of Well 5223 Feet
Show depth and thickness of all water, oil and gas formations.

OIL, GAS OR WATER RECORDS

CASING RECORD

FORMATION	CONTENT	FROM	TO	SIZE	PUT IN	PULLED OUT
		Surface	204'	8 5/8"	Yes	No

Describe in detail the manner in which the well was plugged, indicating where the mud fluid was placed and the method or methods used in introducing it into the hole. If cement or other plugs were used, state the character of same and depth placed, from _____ feet to _____ feet for each plug set.

Surface to 15' -- 10 Sack Cement Plug
15' to 130' -- Mud
130' to 190' -- 20 Sack Cement Plug
190' to Total Depth -- Mud.

RECEIVED
STATE CORPORATION COMMISSION
02-28-62
FEB 28 1962


CONSERVATION DIVISION
Wichita, Kansas

Name of Plugging Contractor Natural Gas Drilling, Inc.
Address P. O. Box 1615, Oklahoma City, Oklahoma

STATE OF Kansas COUNTY OF Sedgwick
Arvel C. Smith (employee of owner) or (owner or operator) of the above-described well, being first duly sworn on oath, says: That I have knowledge of the facts, statements, and matters herein contained and the log of the above-described well as filed and that the same are true and correct. So help me God.

(Signature) Arvel C. Smith

SUBSCRIBED AND SWORN to before me this 26th. day of February, 19 62

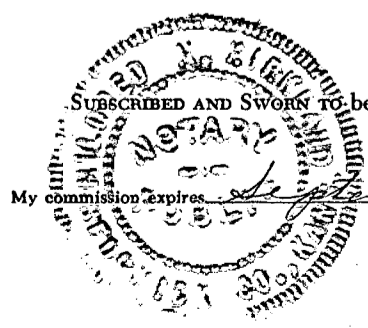

(Address) _____
Mildred M. Kirkland
Notary Public.